90684

T. 34S., R.2E., W. M.

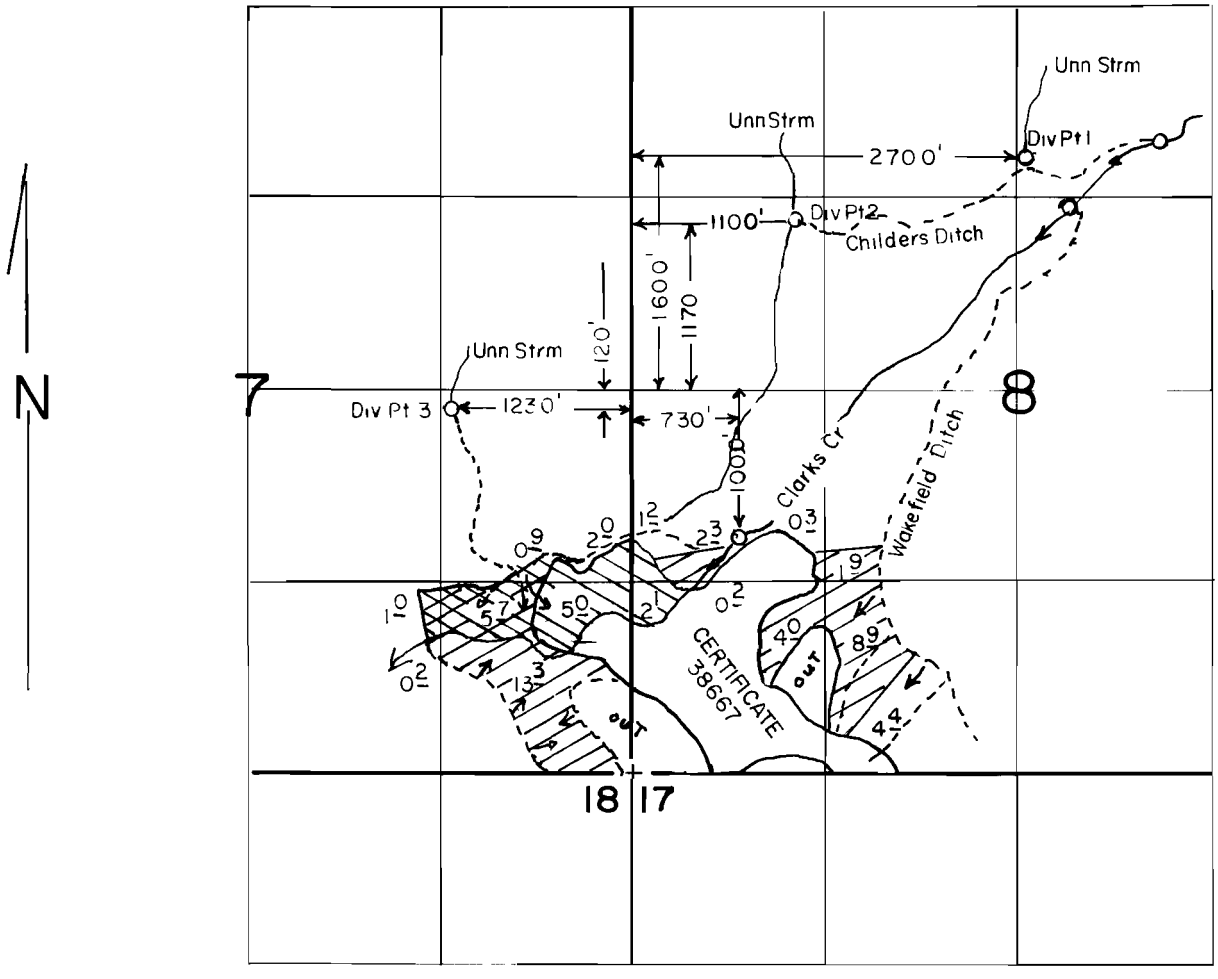

SCALE: 1" = 1320'

FINAL PROOF SURVEY

UNDER

TRANSFER NO. 3291

3293
2635

Application No. ..... Permit No. .....

IN NAME OF

LAWRIE D. & PHYLLIS RUTHERFORD

Surveyed JUNE 28 1989, by B S JAMES

Transfer No 3291 Primary 2635

Transfer No 3293 Supplemental

40129-279-165R

11-16-89 DM