


S.F  
32765

T. 38 S. R. 1 E. W. M

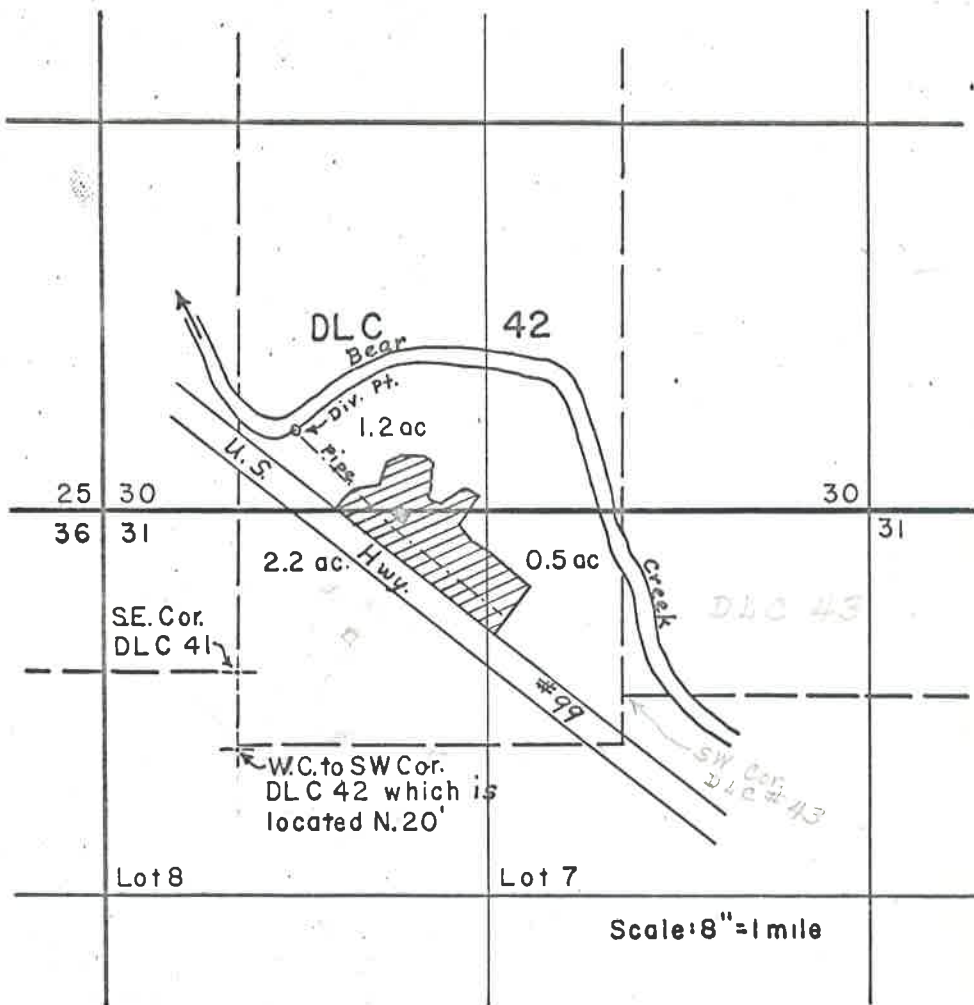

FINAL PROOF SURVEY  
UNDER

Supplemental Findings Page 249  
 Application No. \_\_\_\_\_ Permit No. \_\_\_\_\_  
 IN NAME OF  
 Hoyt D. & Ruth M. Aderholt  
 Formerly Sam K. Pollard right

CERT. 32765

PRIORITY-DEC. 1908

Surveyed Sept. 10, 1965, by D.C. Hendrix