

OFFICE OF STATE ENGINEER


RECEIVED

OCT 17 1911

SALEM, OREGON

T. 9. S. R. 7. E.

Scale: One inch = $\frac{1}{2}$ Mile

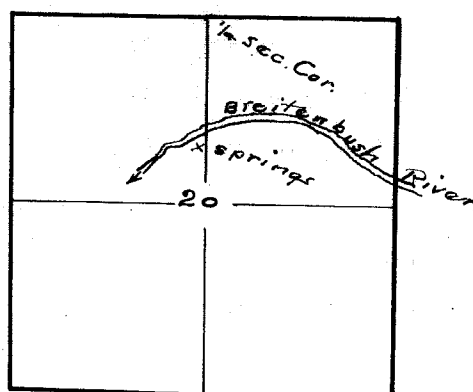

Application No. 17
Permit No. 14
Certificate No. 3292

Surveyors Certificate.

I, W. J. Culver of Salem Oregon do hereby certify that this map was made from notes taken during an actual survey made by me on Oct. 4, 1911 and that it correctly represents the works described in the accompanying application together with the location of streams in the immediate vicinity.

W. J. Culver

Note:

The springs applied for are more particularly described as being located on the south side of the Breitenbush river and within the following boundaries. Beginning at a point 24.90 Chains South of the $\frac{1}{4}$ section Corner between Sections 17 and 20 in T. 9. S. R. 7. E; thence South 3.14 Chains; thence West 3.72 Chains; thence North 80 links; thence Easterly to the place of beginning. The central part of the Spring grounds being S. 3° 15' W 27 Chains from the above named $\frac{1}{4}$ Sec. Cor.

W. J. Culver

1273