

STA 2180 & DIME

48'

INVERT EL. 1060.25

POND OUTLET
10" CONC. PIPE

POND

HOR. SCALE 1 INCH = 10 FT.
VERT. SCALE 1 INCH = 10 FT.

SURFACE DRAIN
@ STA 2180



CREEK LBR. CO. POND
AT
PHY, ORE.

PIPELINE IN GOV'T LOTS 3,
TRACTS", IN SECTION 19,
7 3/4. R&B SW. WM.
OREGON

SALES: AS SHOWN


ROBT. M. THOMPSON P.E.

NO.	STRUCTURE NO. 1. 12. 12 CH. 1. 10	DATE
NO. 1	8' W. 12' 10' 10'	BY
NO. 2	GRADES CHECKED	
NO. 3	NOTED	
NO. 4	GRADES CHECKED	
NO. 5	NOTED	
NO. 100	GRADES CHECKED	

A - CAPACITY CURVE

SURFACE ACRES

849 937 1.08

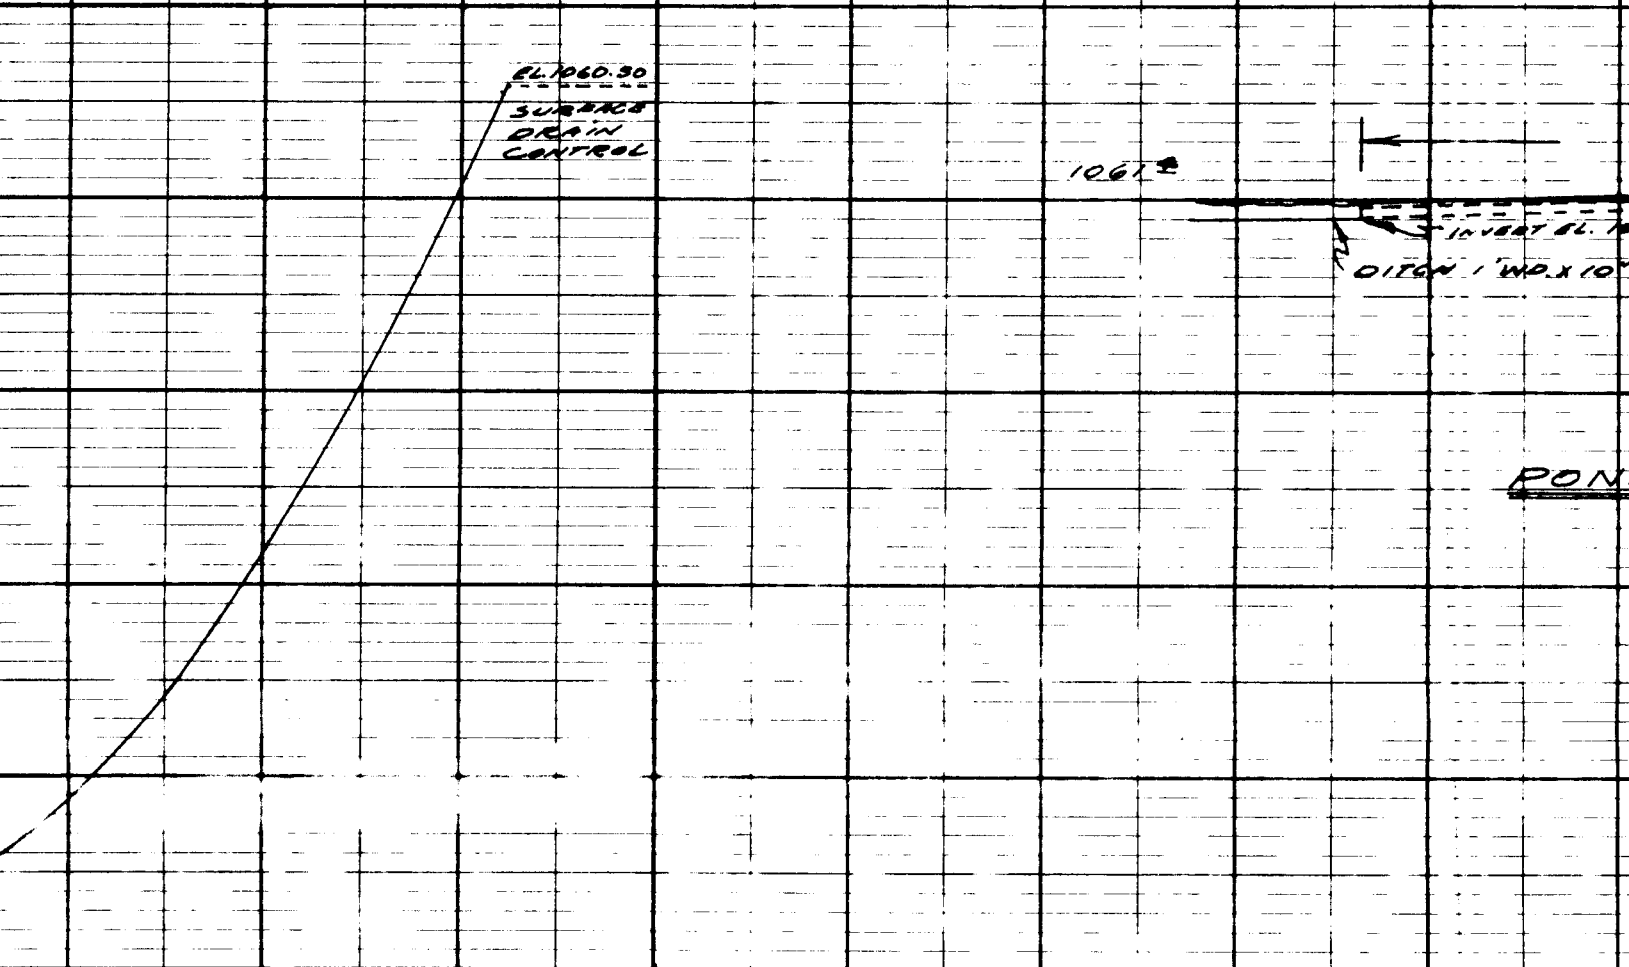

1056 1058 1060
ELEVATION

EXISTING MURPH
MUR
SHOWING LOC POND AT
4, 5 AND MADRONA
TWP 3
TOS
30
July 31, 1967



DIKE


ARE

BM 1208 ORE STATE
HIGHWAY DATUM AT NO.
END APPLIANTS RIVER
BRIDGE. ELEV. 10545

4 291

TO ELEV. 10615

BASE
ELEV. 10500

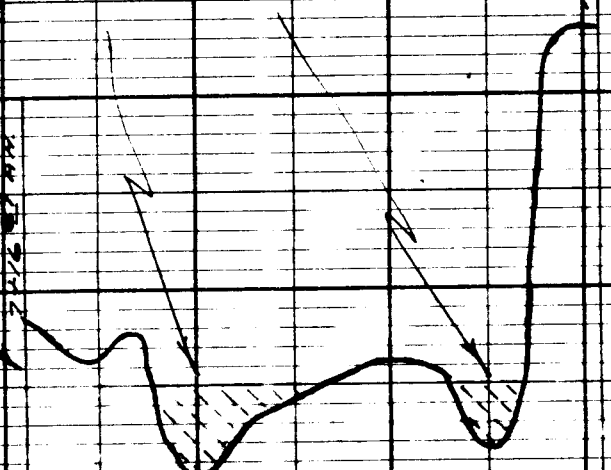

CUT BY

10500

10500


1054

PLAN-PROFILE OF R. E. STANBARD
PAPER MADE AND PRINTED IN U.S.A.
ENGINE DESIGN

PROFILE OF CREST OF EXIST.

HOR. SCALE 1 INCH = 100 FT.

VERT. SCALE 1 INCH = 1 FT.

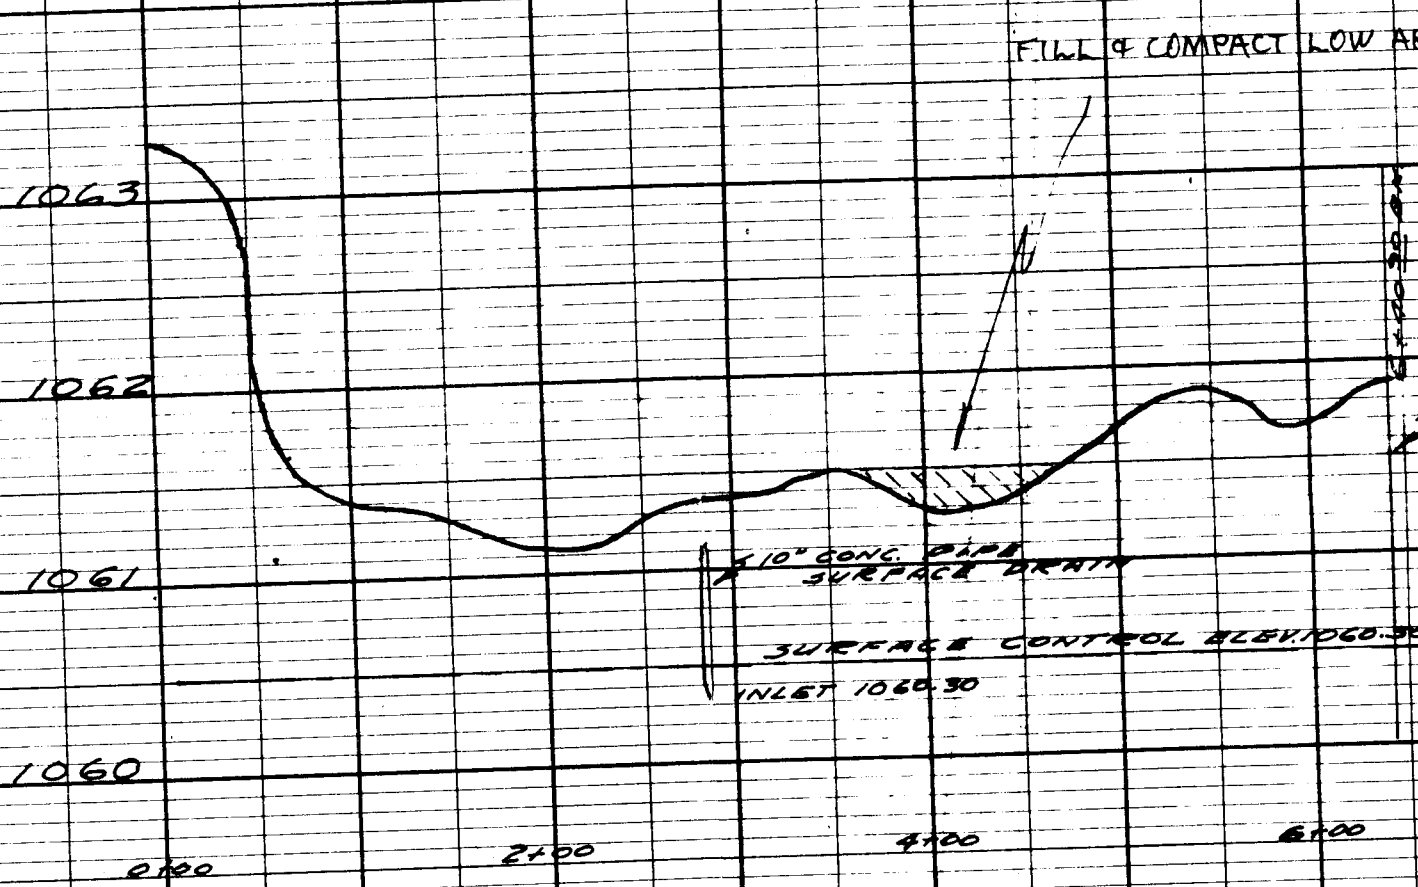

MURPHY
AC




SCALE 1" = 400'


EAST 1/4 COR.
S 366.19
T. 37 S. R. 3 W. W. 4.

E. COR. TRACT 48

15.40.51
17.37.51
18.37.51

NO.	RT. OF WAY CHECKED	BY	DATE
	ALIGNMENT CHECKED		
MOLE BOOK	DATE		
6741	DATE		
	STOLLED		
	SURVEYED		

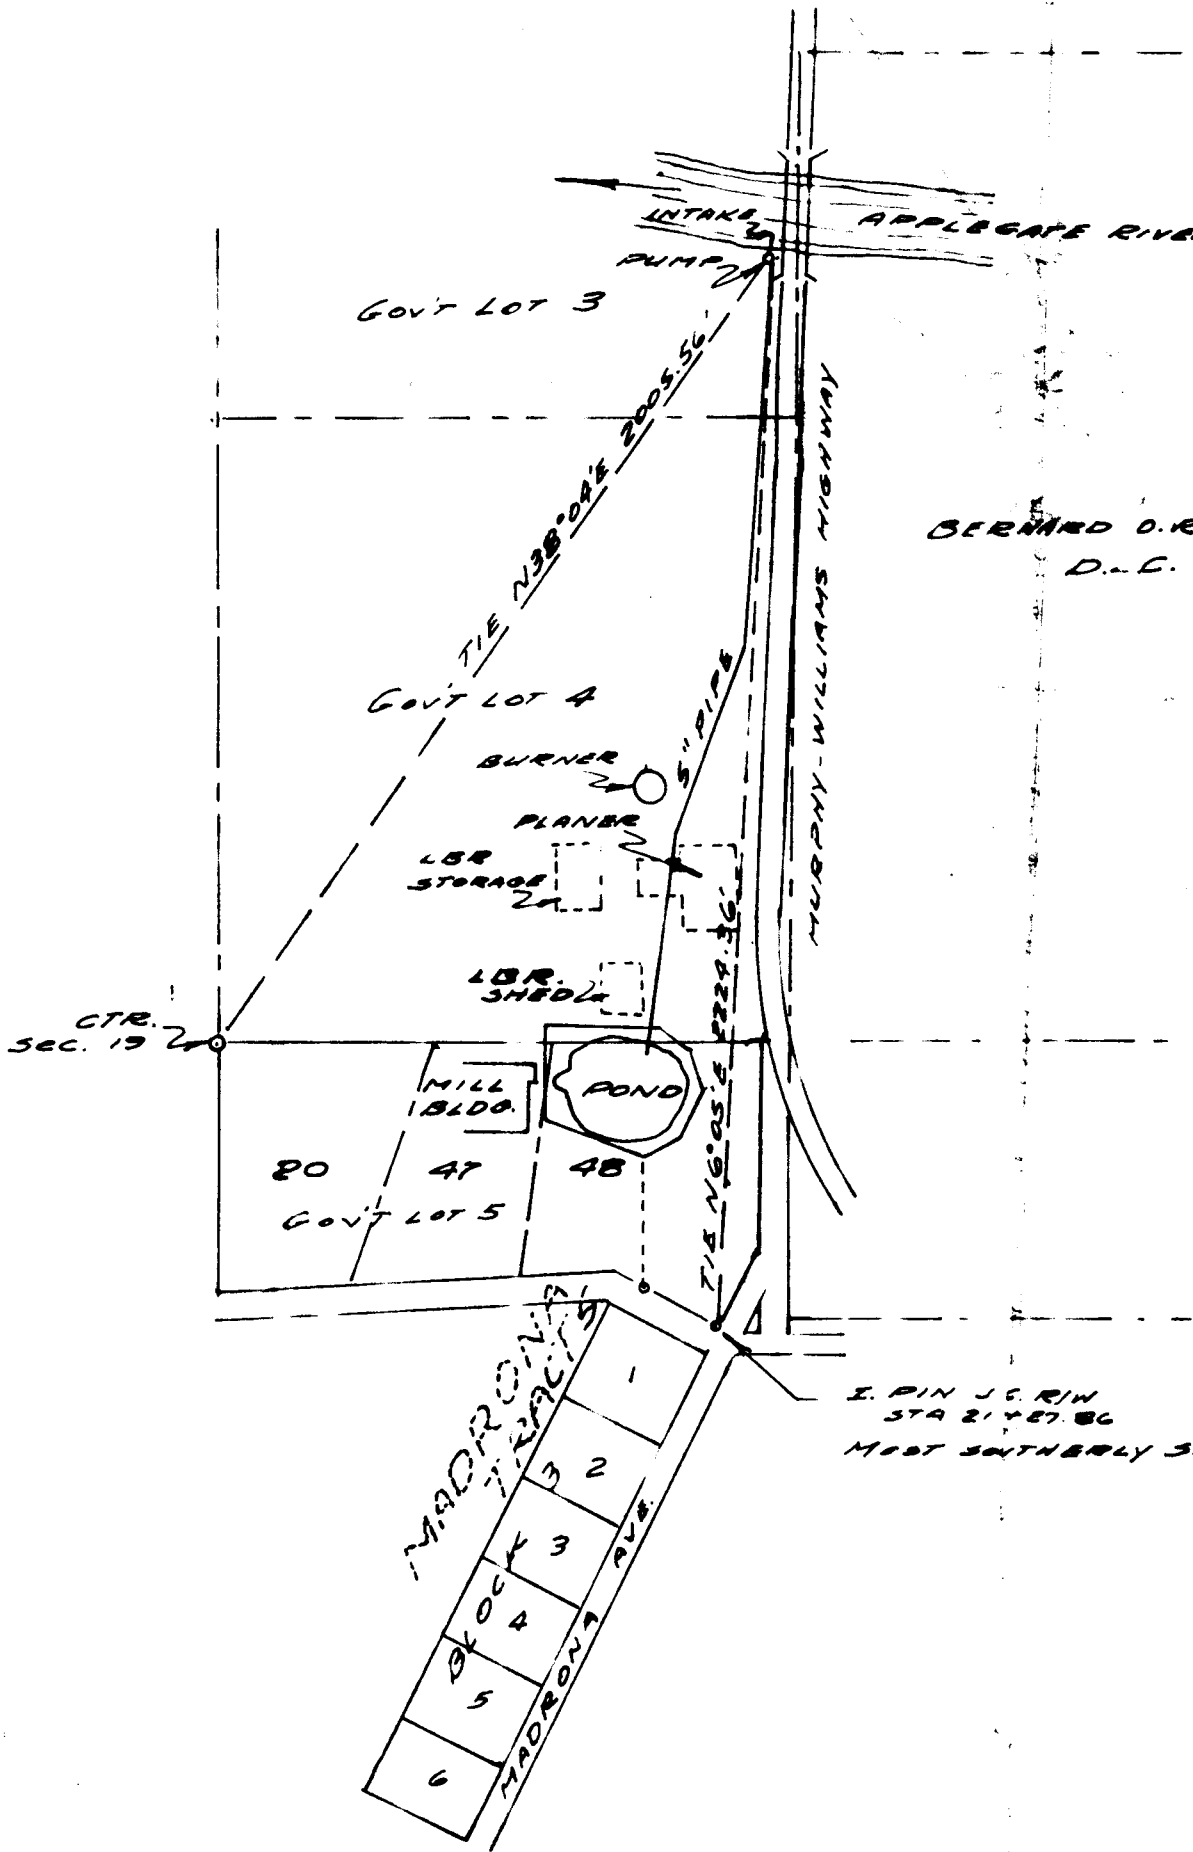

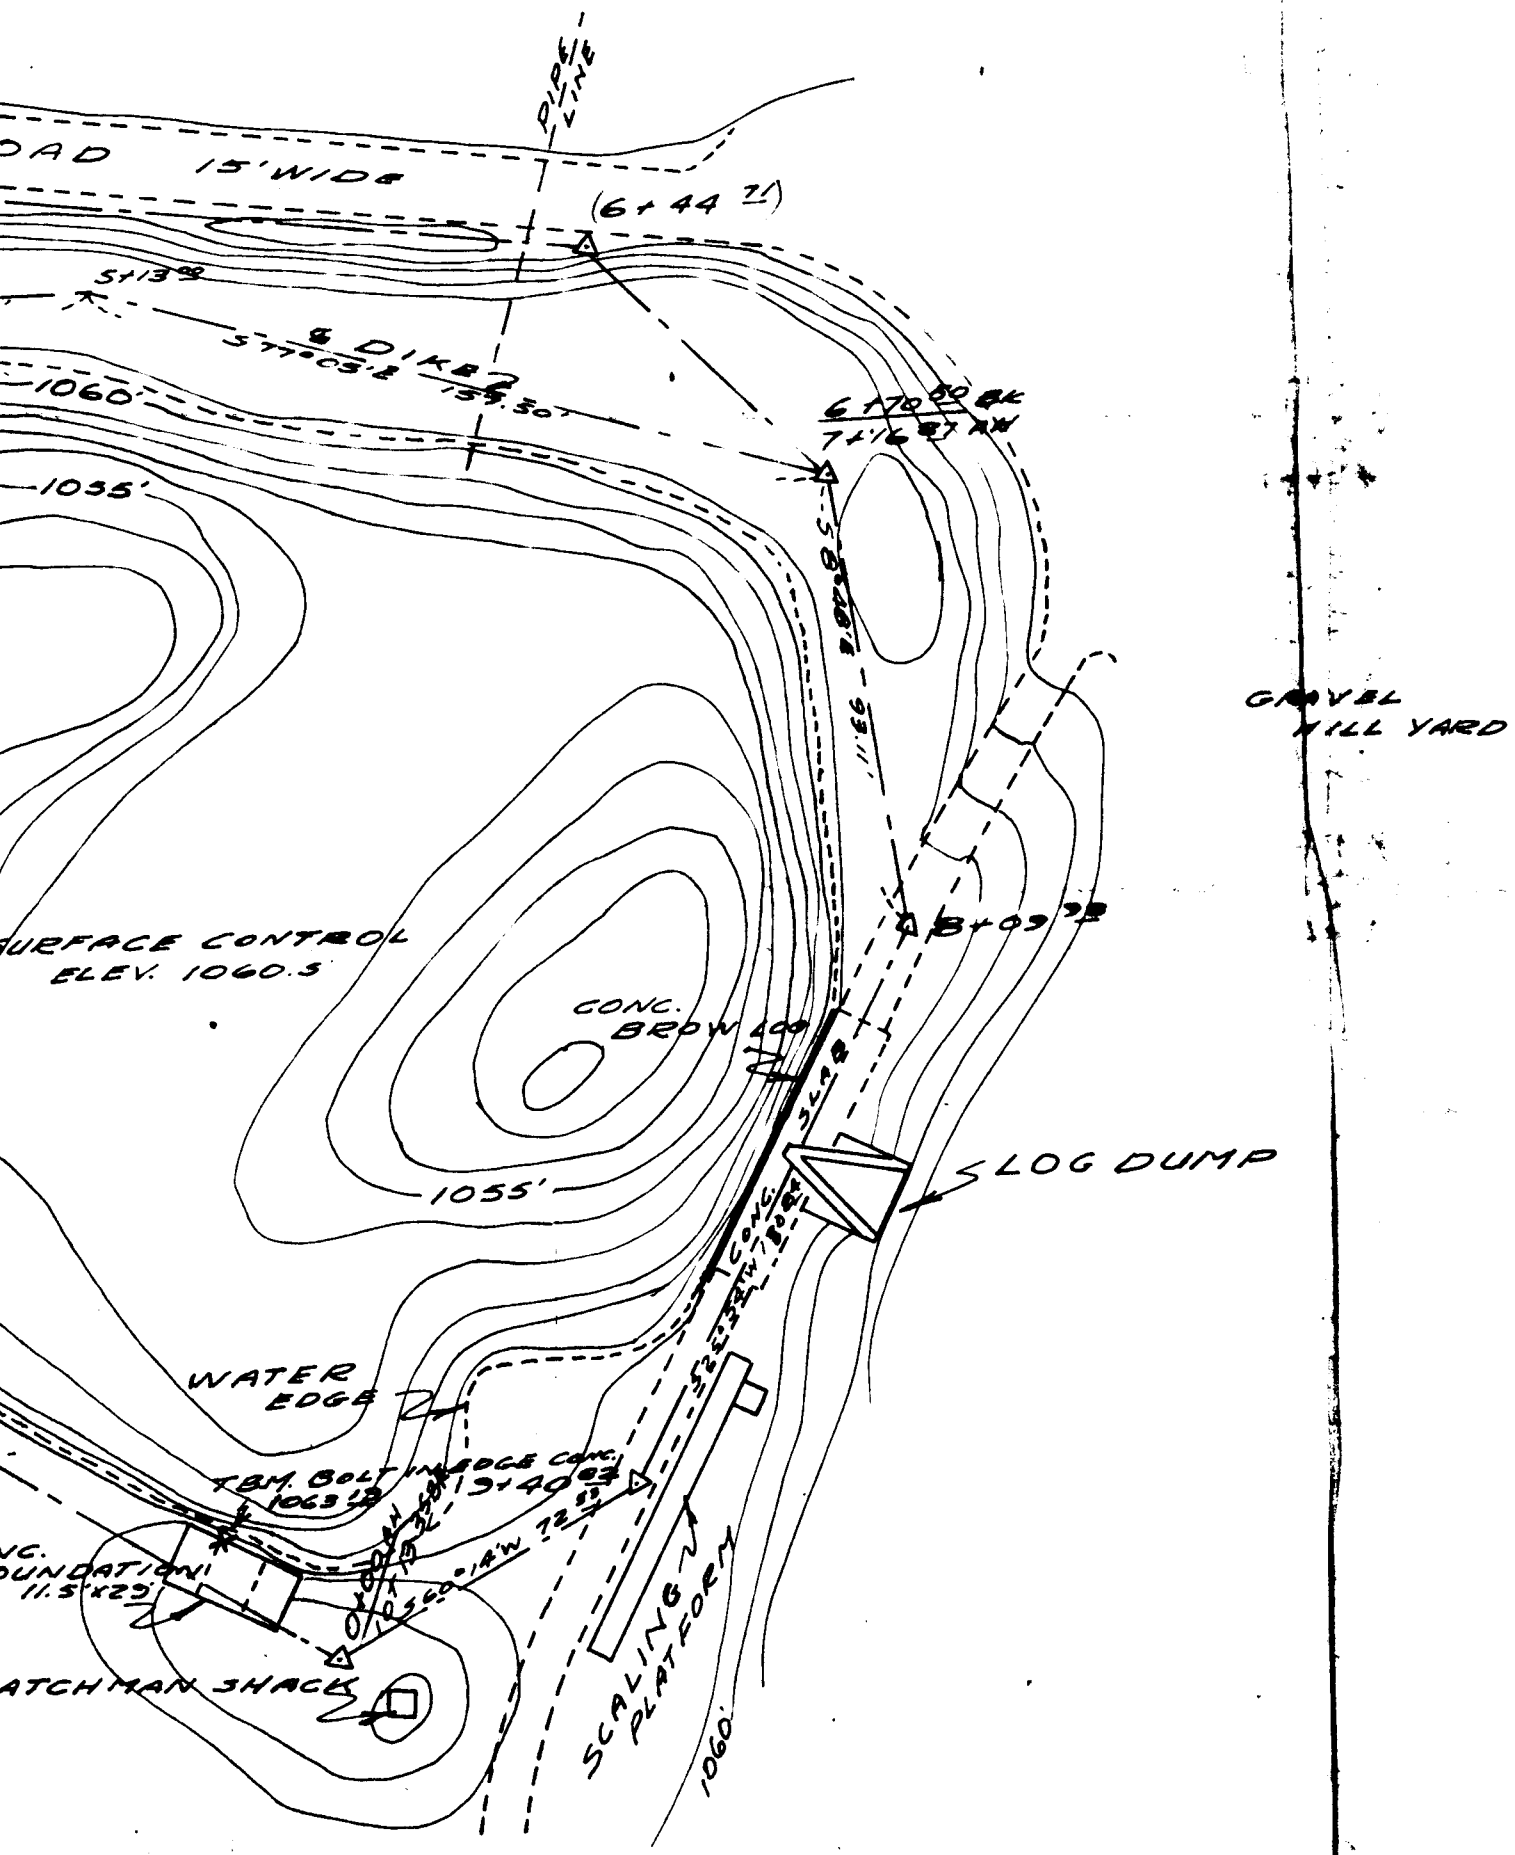

DAD 15' WIDE

PIPE LINE

(6+44.2)

5+13.8

6 DIKE

5+77.05

1060

1055

6+70.8

7+16.8

GRAVEL MILL YARD

SURFACE CONTROL
ELEV. 1060.5

CONC.
BRON

1055

LOG DUMP

WATER EDGE


ATCHMAN SHACK

CONC. FOUNDATION
11.5' X 29'

SCALING PLATFORM

1060

ATCHMAN SHACK

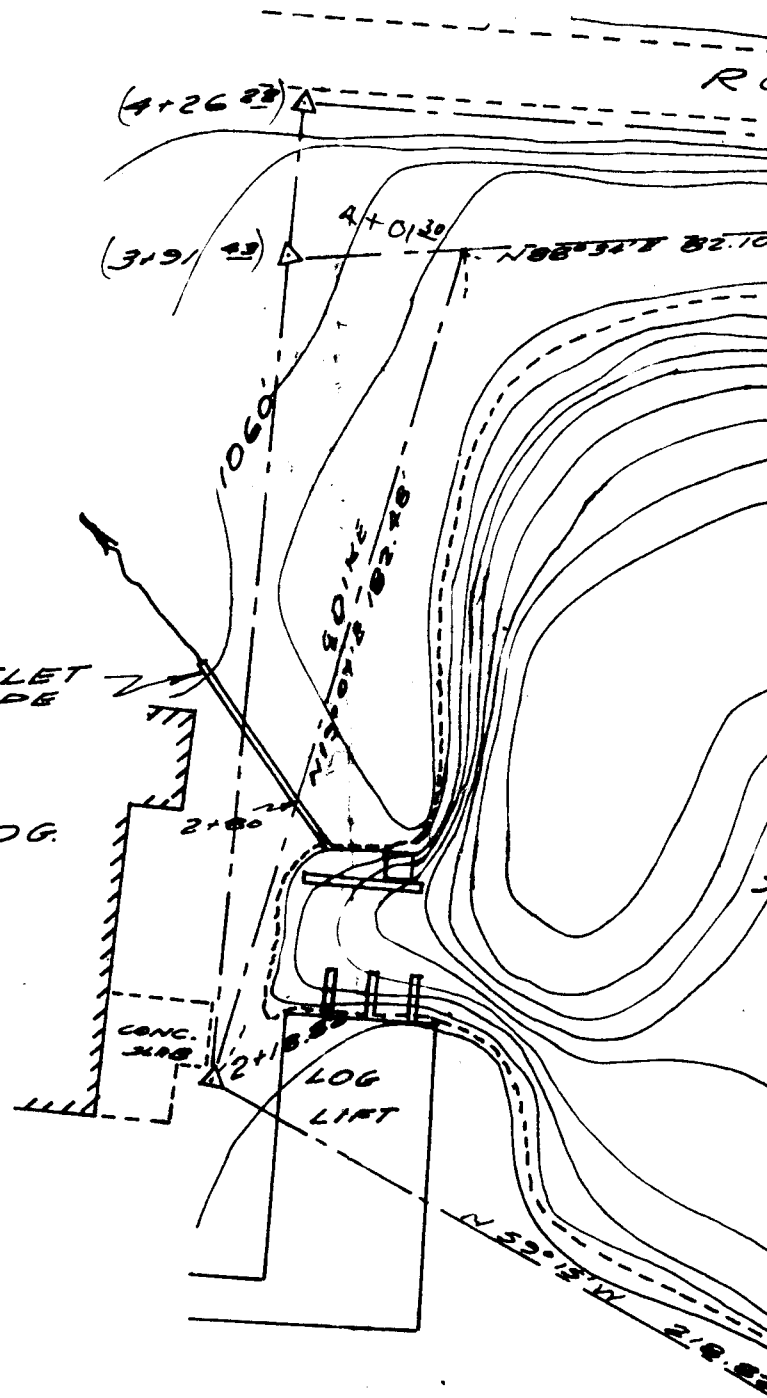

POND OUTLET
10" CONG. PIPE

MILL
BLDG.

CONG.
3.00

LOG
LIFT

SCALE 1" = 40'
CONTOUR INTERVAL 1 FT.

5X40

CO
W