


Permit No. 19956

C 23881
33012
W86

T. 14S. R. 15E. W.M.

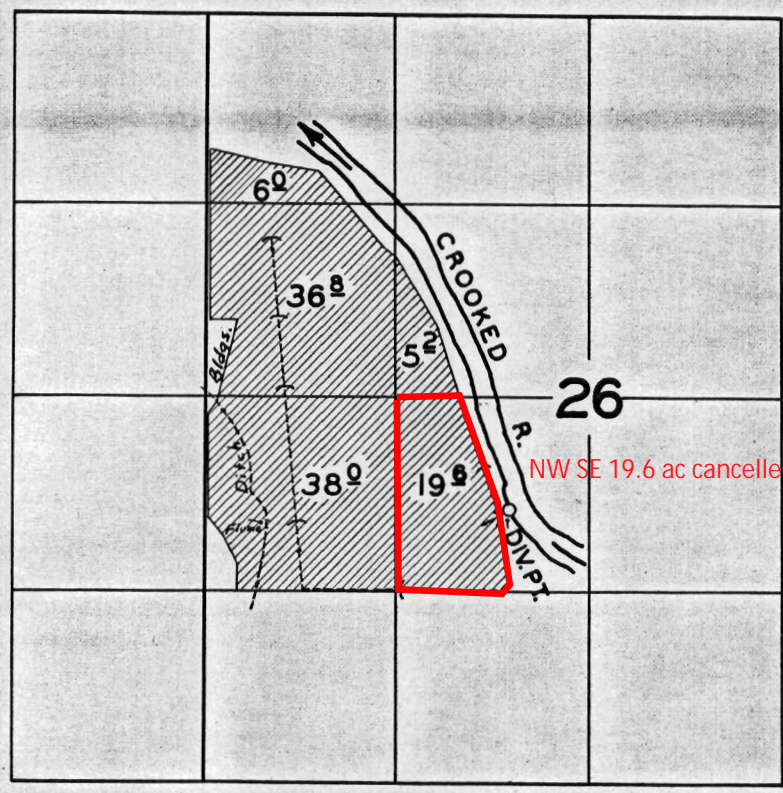

NW SE 19.6 ac cancelled S.O. Vol. 85 Page 541

FINAL PROOF SURVEY UNDER

Application No. 25184. Permit No. 19956.
IN NAME OF

EARL FOREST

Surveyed AUG. 4. 1957., by C.O. BARTELS

P# 19956
1957U