


Permit No. 19956

C 23881
33012
W86

T. 14S. R. 15E. W.M.

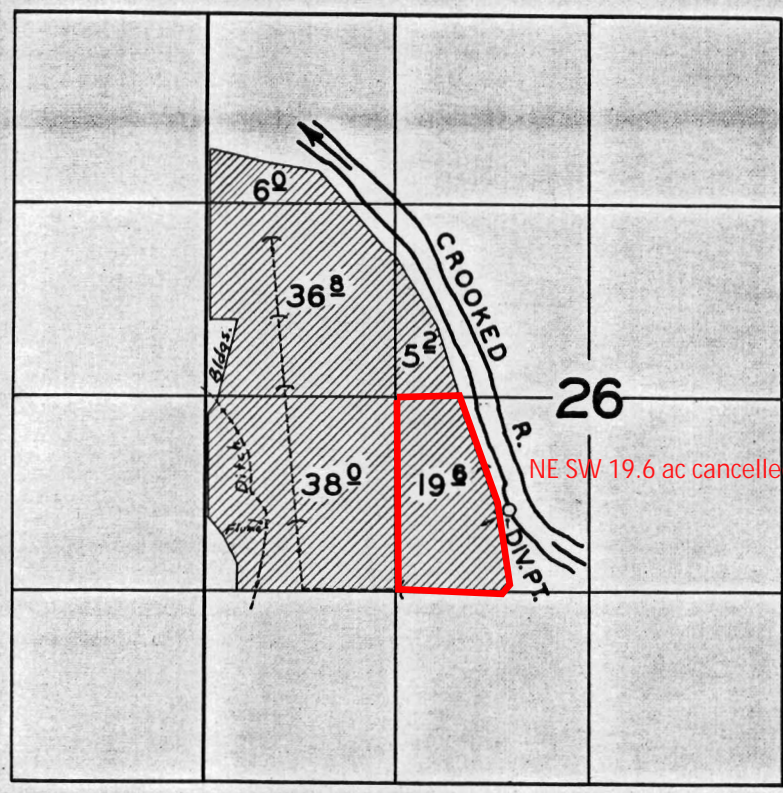

NE SW 19.6 ac cancelled S.O. Vol. 85 Page 541

FINAL PROOF SURVEY
UNDER

Application No. 25184 Permit No. 19956
IN NAME OF

EARL FOREST

Surveyed AUG. 4. 1957, by C.O. BARTELS

P# 19956
1957U