


Permit No. 19956

C 23881
33012
W86

T. 14S. R. 15E. W.M.

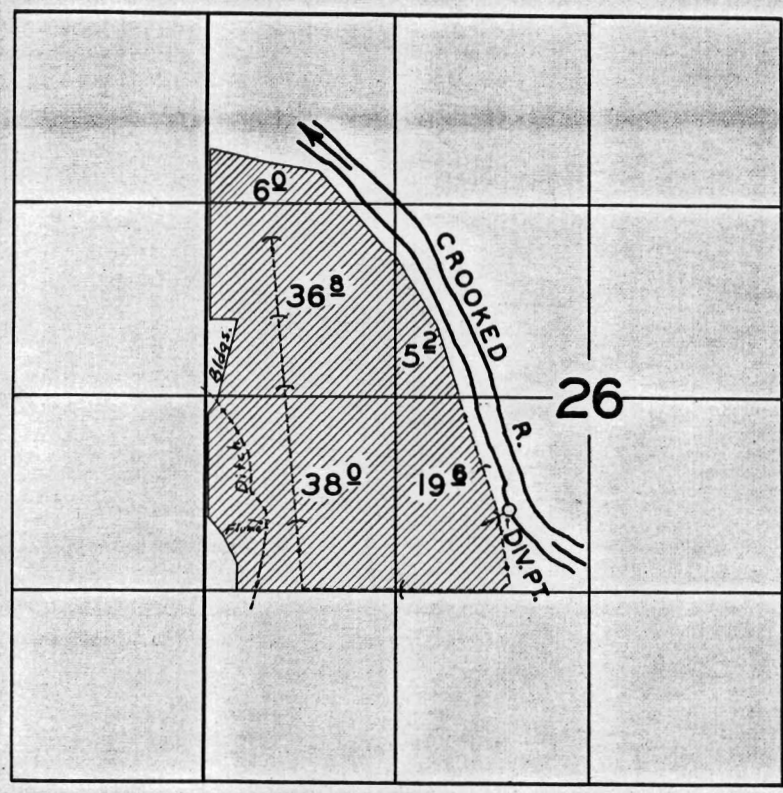

FINAL PROOF SURVEY UNDER

Application No. 25184. Permit No. 19956.
IN NAME OF

EARL FOREST

Surveyed AUG. 4. 1957., by C.O. BARTELS

P# 19956
1957U