


T. 25 S.R. 7 & 8 W.W.M.

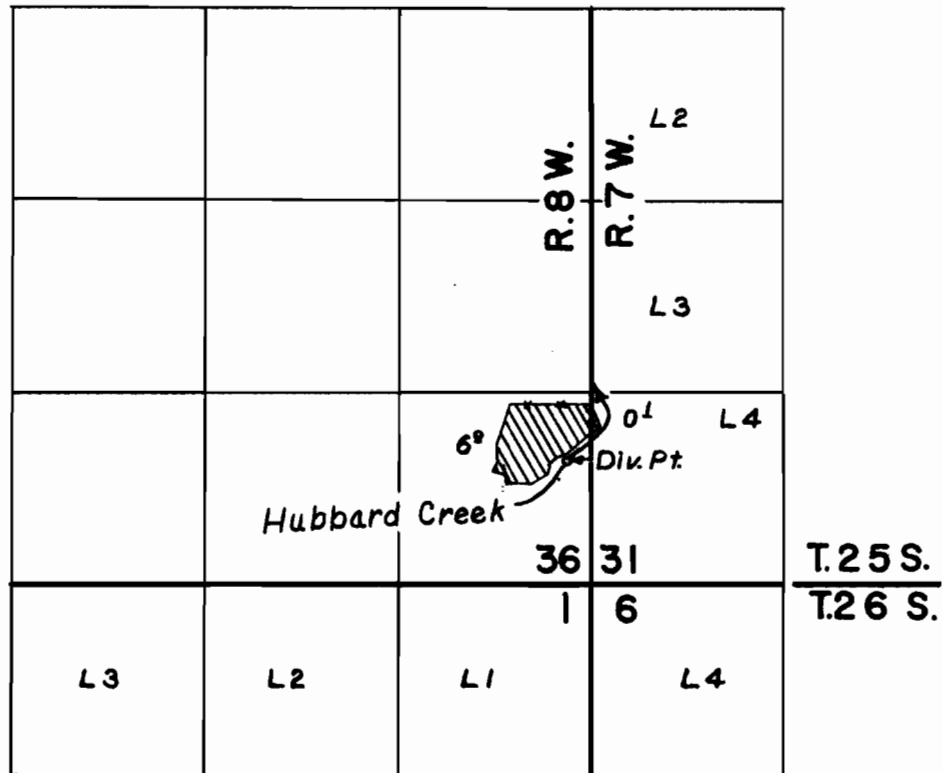

FINAL PROOF SURVEY UNDER

Application No. 34834 Permit No. 27348
IN NAME OF

CHARLES R. BRIGGS

Surveyed Aug 2 1962, by C.R. Baker