


T. 28 S.R. 7 W.W.M.

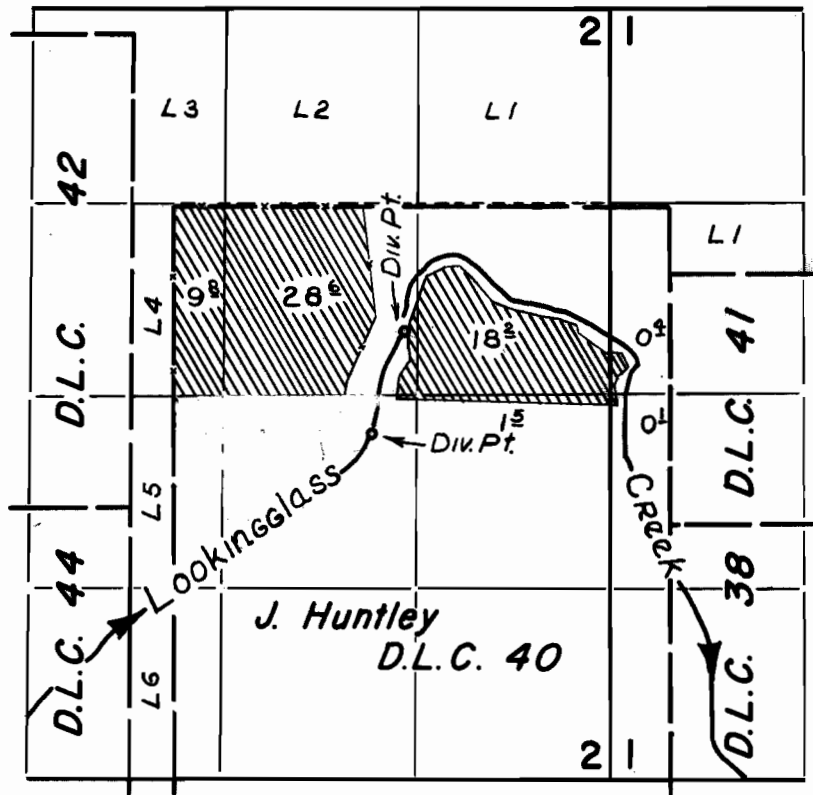

FINAL PROOF SURVEY
UNDER

Application No. 32811.. Permit No. 25902..
IN NAME OF

FRED SCHULZE

Surveyed July 31 1962., by C.R. Baker.....