


T. 26 S. R. 4 W. W. M.

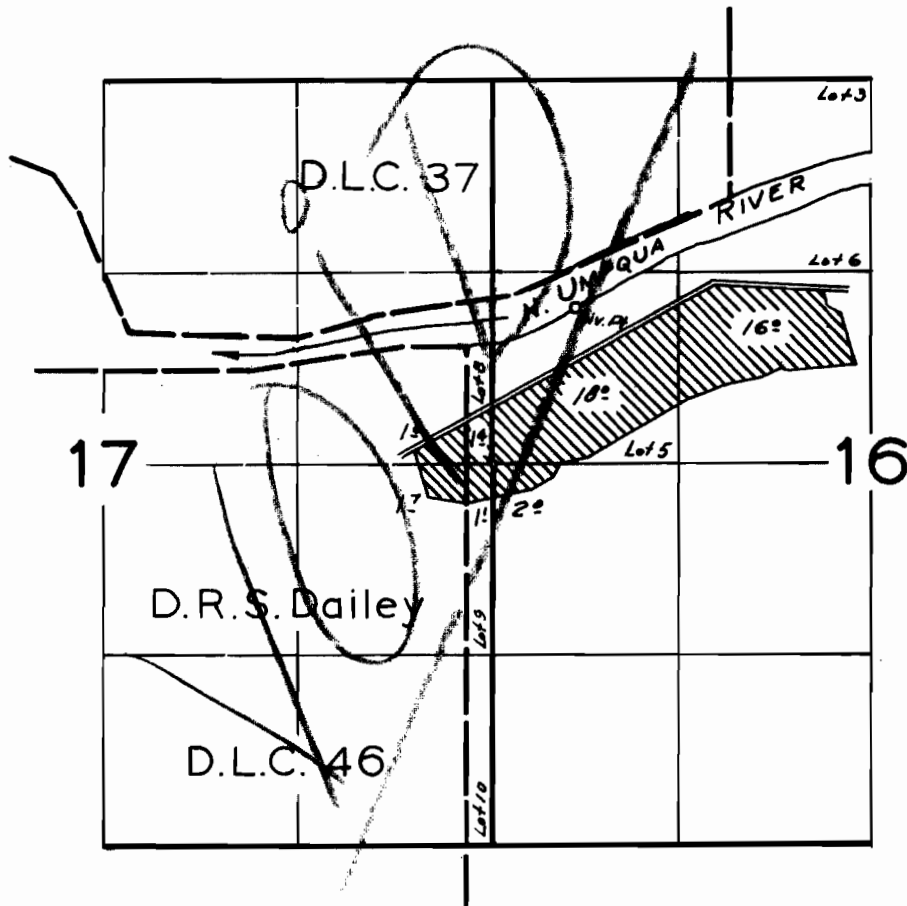


FINAL PROOF SURVEY
UNDER

Application No. 31153..... Permit No. 24551.....
IN NAME OF

NYE & ALLENBY

Surveyed June 23 1959, by *R. Jackson*

T. 26S. R. 4W. W.M.

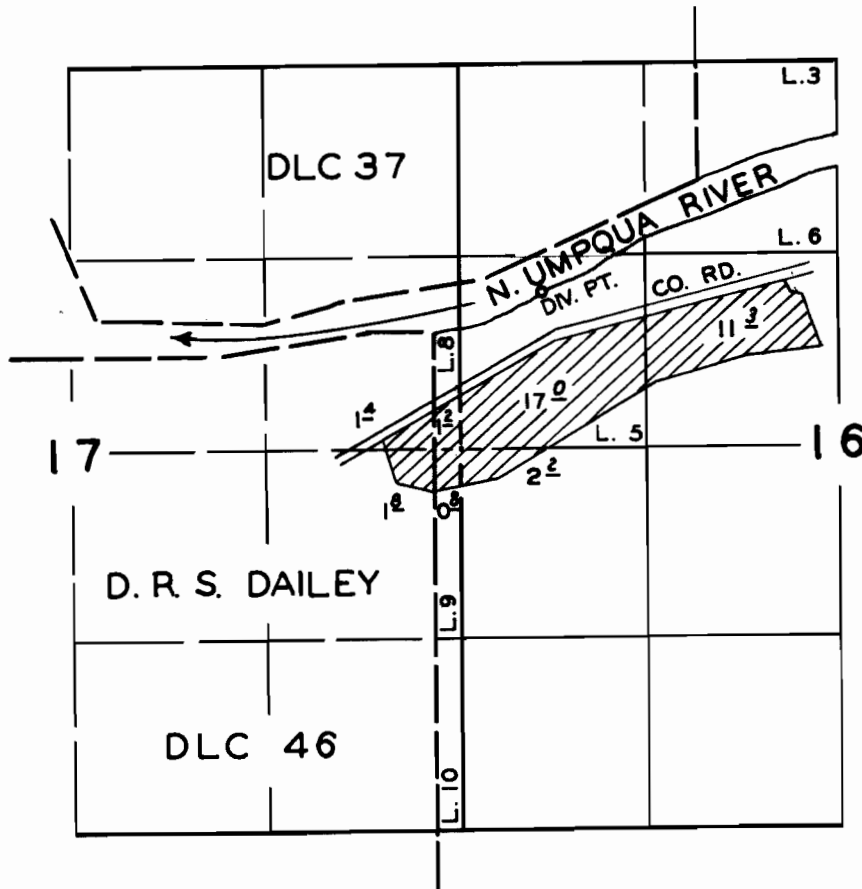

FINAL PROOF SURVEY
UNDER

Application No. 31153 Permit No. 24551
IN NAME OF

NYE & ALLENBY

Surveyed ~~JUNE 23 59~~ **AUG. 26 1960**, by ~~R. H. JACKSON~~ **C. O. BARTELS**