


T.29&30 S.R.17 E.W.M.

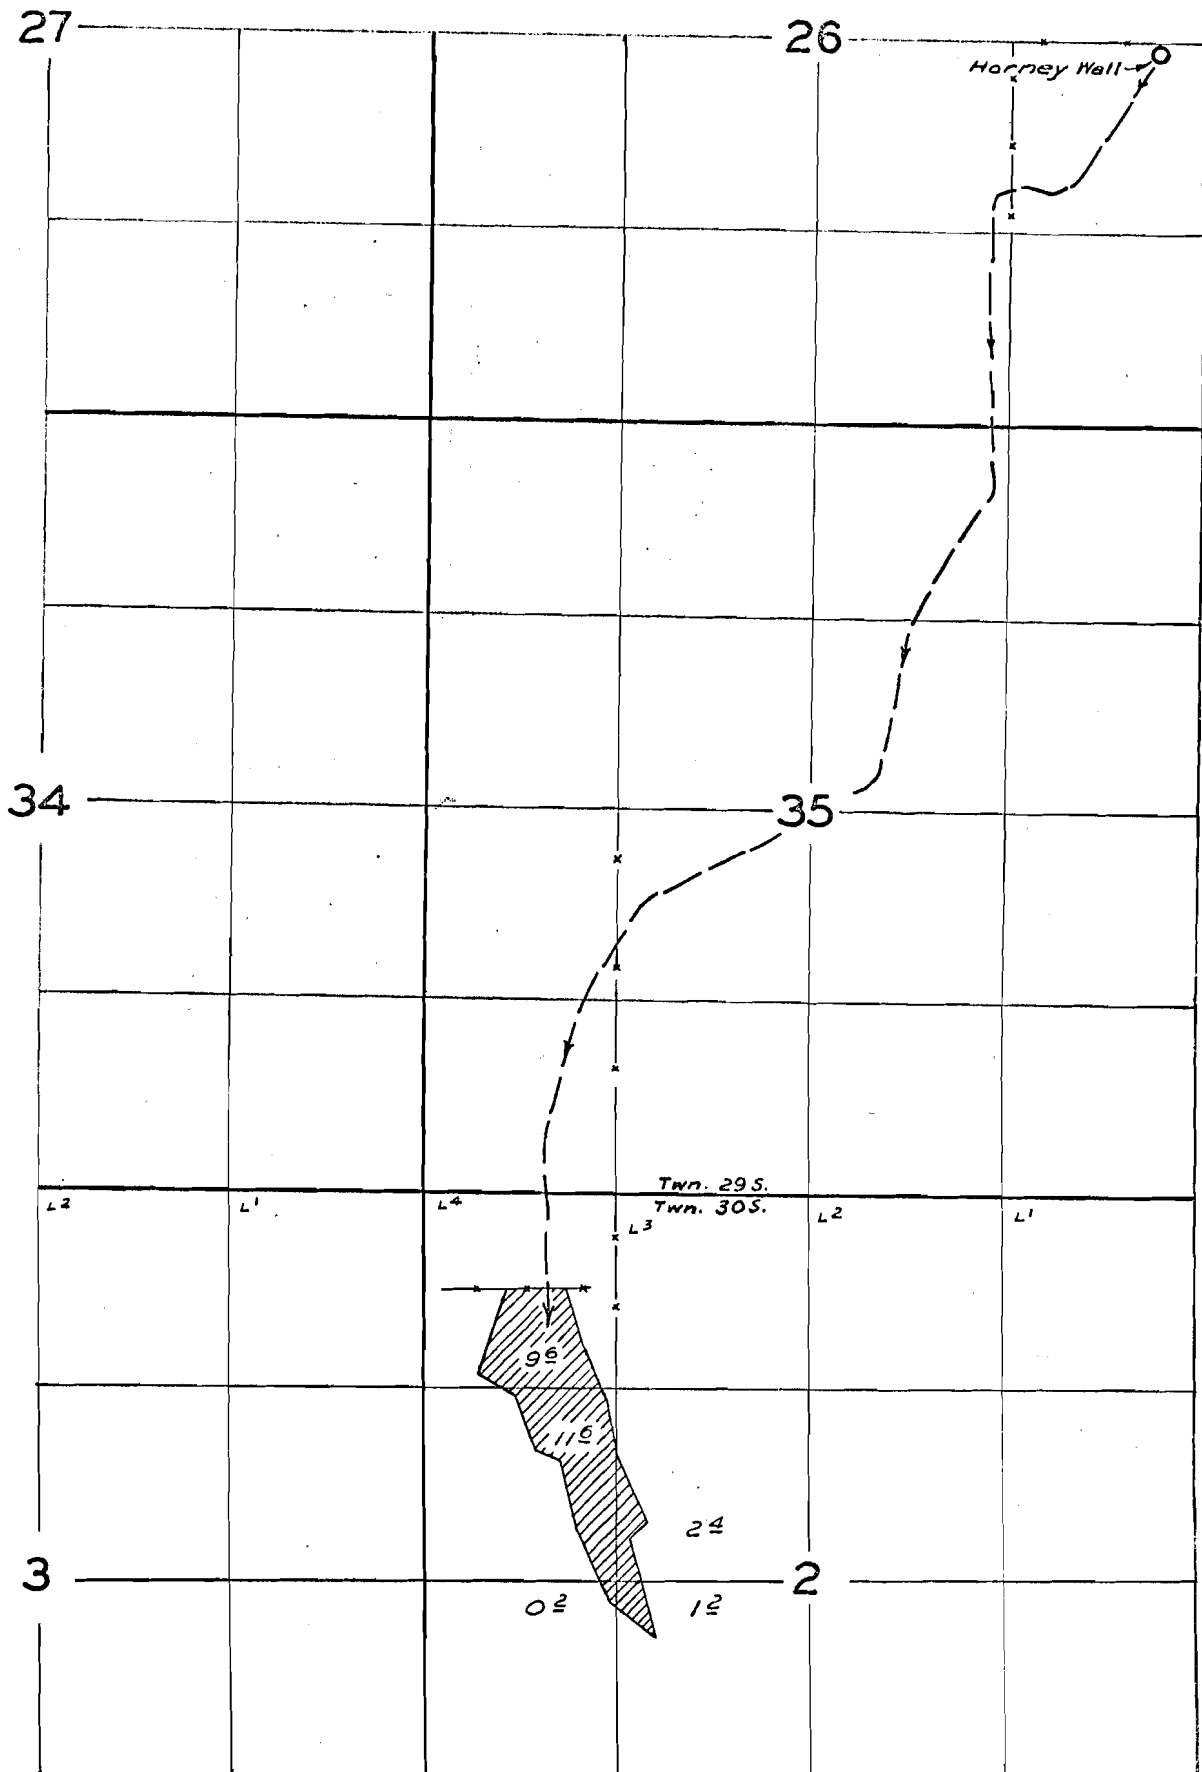

FINAL PROOF SURVEY

UNDER

Application No. U-143 Permit No. U-139

IN NAME OF

ROSS M. SMALL & BELLE CARLON

Surveyed May 25 1946, by Jim Bunnell

Inspected May 7, 1959 by M. Bish