


T. 21 S. R. 2 W. W.M.

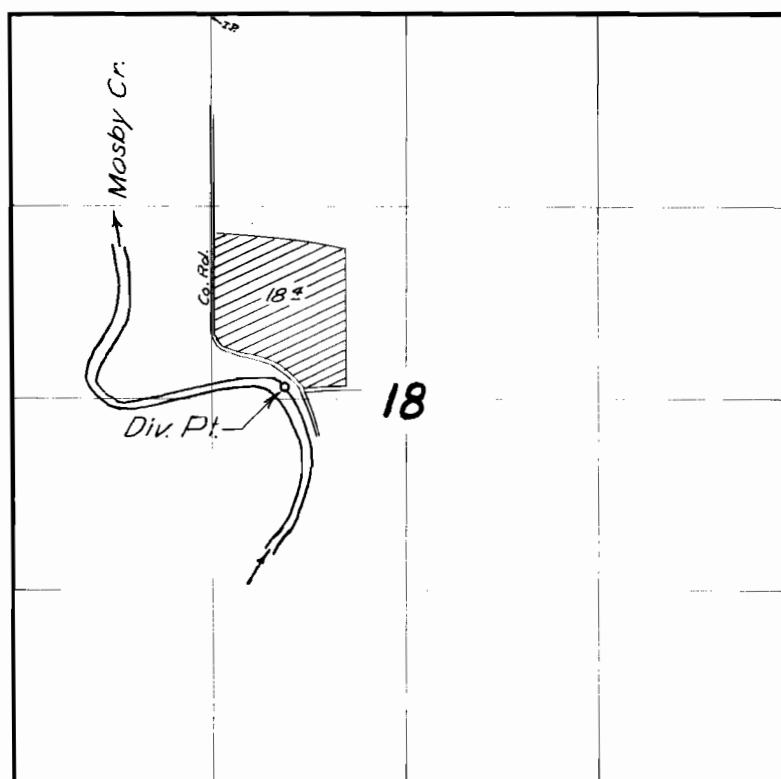

FINAL PROOF SURVEY
UNDER

Application No. 29117 Permit No. 22663
IN NAME OF

George P. & Dorothy J. Woodworth

Surveyed April 10, 1957, by *m. Bish*