


T.5S.R.IW.W.M.

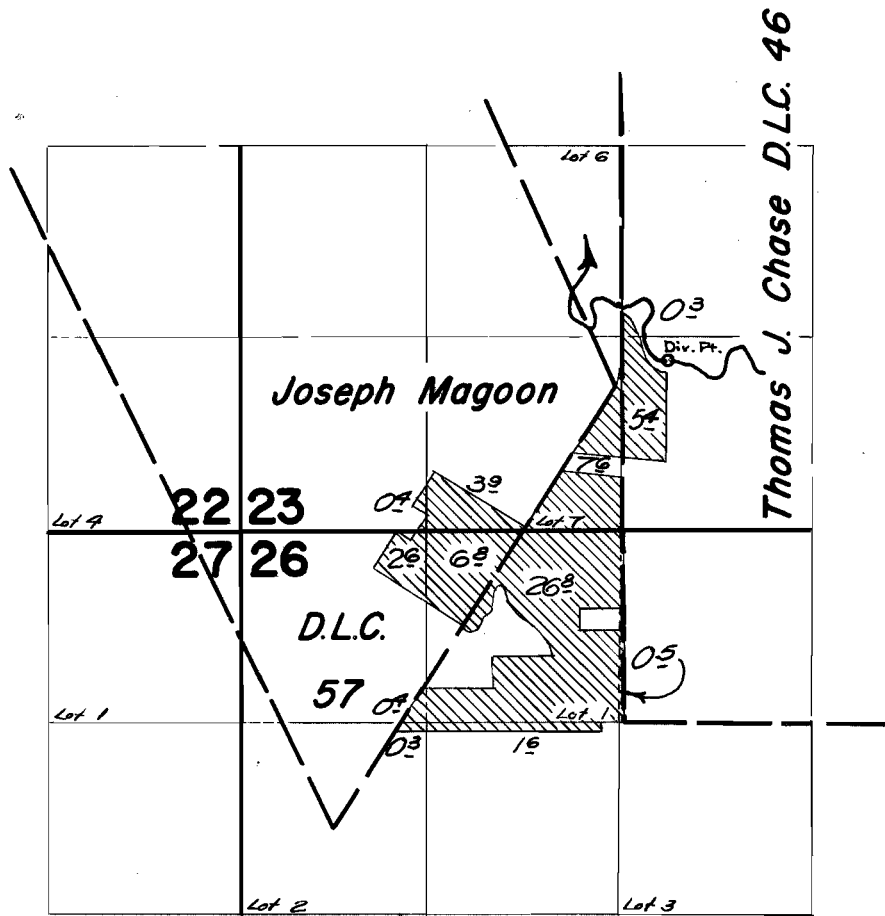

FINAL PROOF SURVEY UNDER

Application No. **23875** Permit No. **18894**
IN NAME OF

JOHN & JULIA EDNA STENGER

Surveyed *Feb. 27 1956*, by *R.D. Best*