


T.5S.R.1W.W.M.

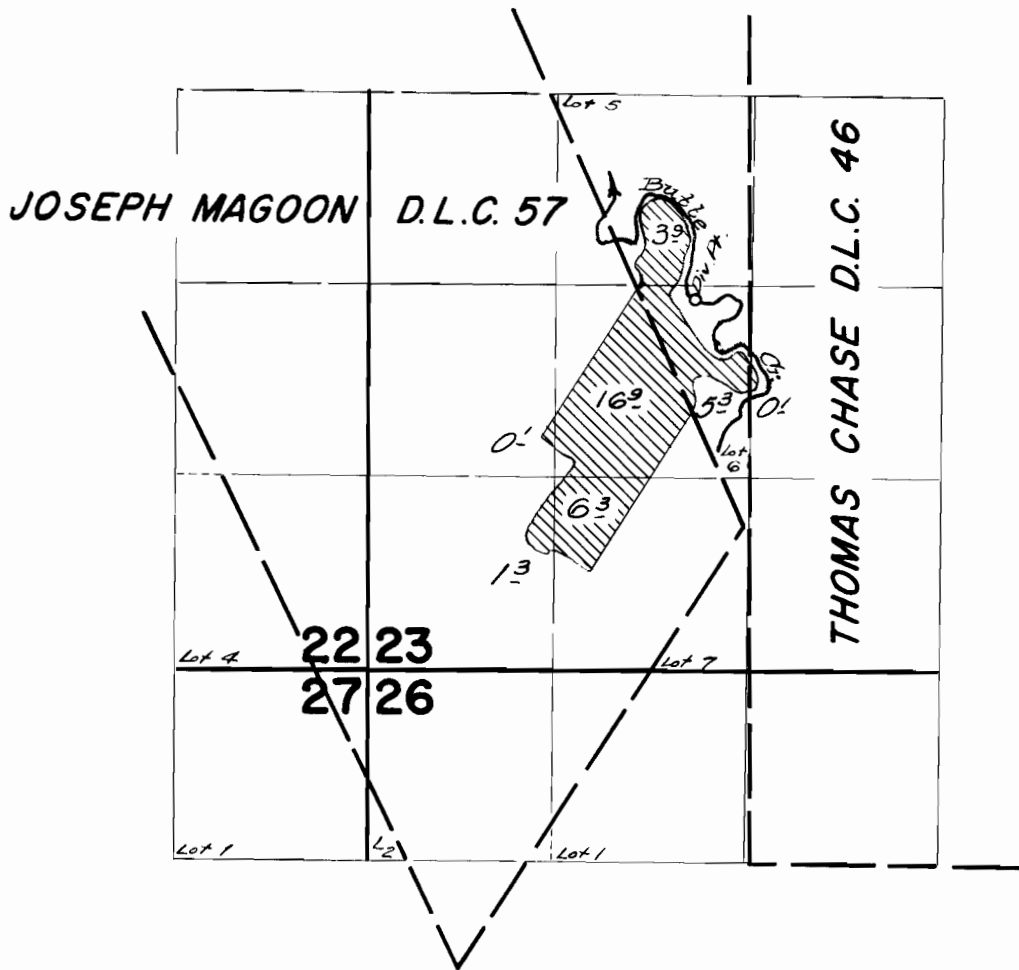

FINAL PROOF SURVEY UNDER

Application No. **23482** Permit No. **18574**
IN NAME OF

FRANCIS M. & FRANCES M. KEETON

Surveyed Feb. 29 1956. by *R.D. Best*