


SURVEYOR'S CERTIFICATE

I, W. E. Anderson, County Surveyor of Tillamook Ore. do hereby certify that this map was made from notes taken during an actual survey made by me in March 1957, and that it correctly represents the works herein.

W. E. Anderson

MEHALEN BAY

S 71° 13' E 1/4 S.P.R.

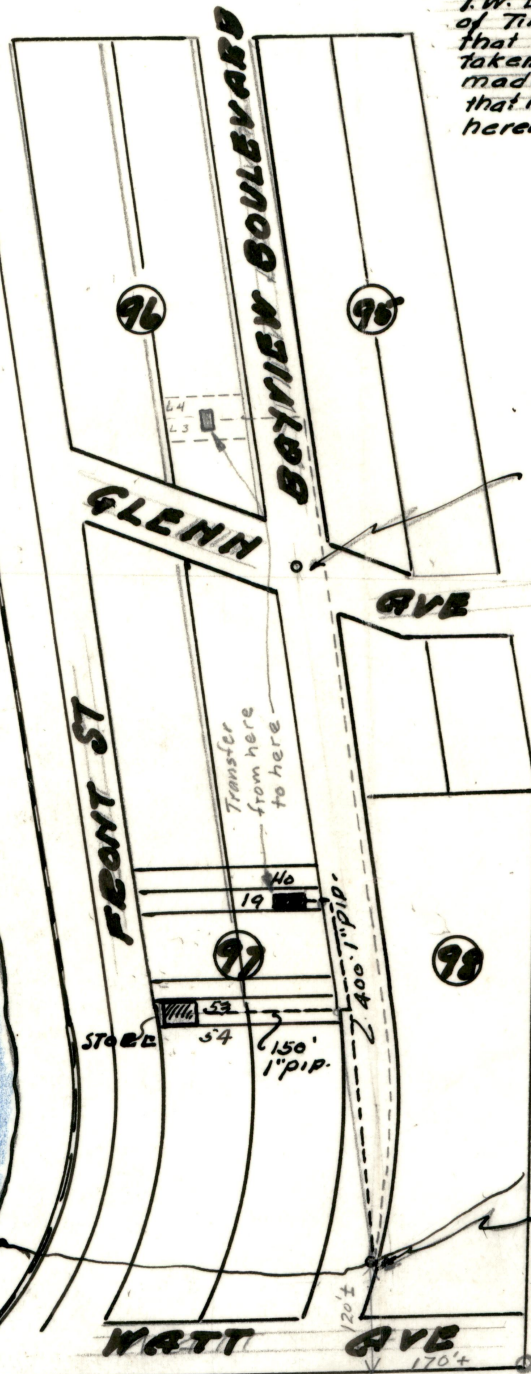

500' FORBAYLE IN 200' INTERSECTION OF STREETS

Application No. 32965

Permit No. 26071

C. F. McLAUGHLIN

WATER RIGHT
IN BRIGHTON BEACH ORE
Scale 1" = 200'

W. E. Anderson

point of diversion 1/2" I.P. 100'
S 763.24 E 75.37 from
INTERSECTION OF GLENN AVE
& BAYVIEW BOULEVARD IN
BRIGHTON BEACH

Int. Pt. 2" x 3" I. P. buried 6"

456.27 ft N & 1322.55 ft W from

1/4 Cor. Secs. 9 & 16

G-58 - Vol 14, P. 35