


T.2S.R.4E.W.M.

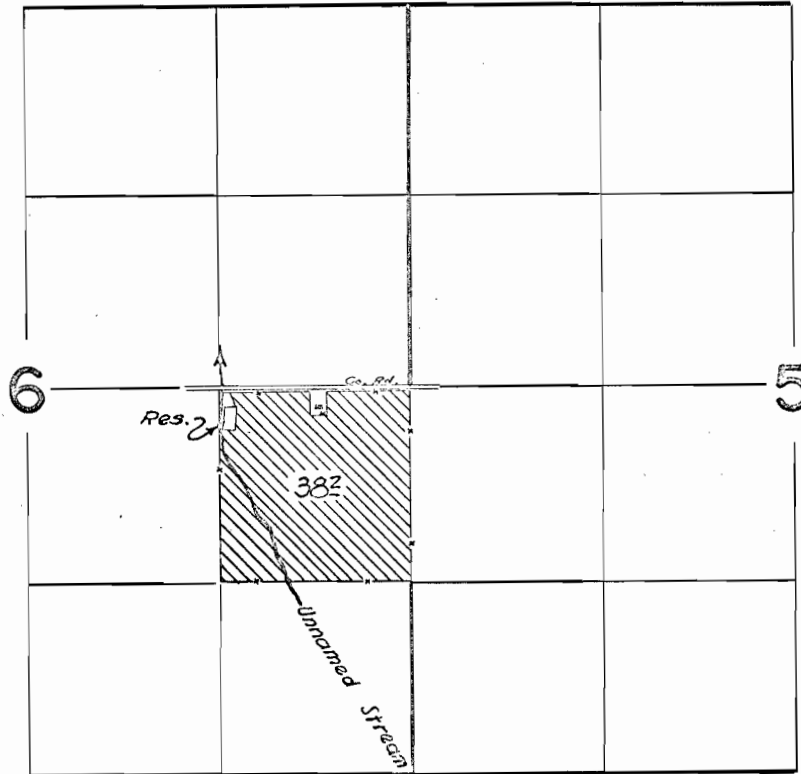

FINAL PROOF SURVEY
UNDER

Application No. R-34503 Permit No. R-2580
34504 27137
IN NAME OF

ARNOLD MOORE JR.

Surveyed May 2 1963, by [Signature]