


T.2S.R.4E.W.M.

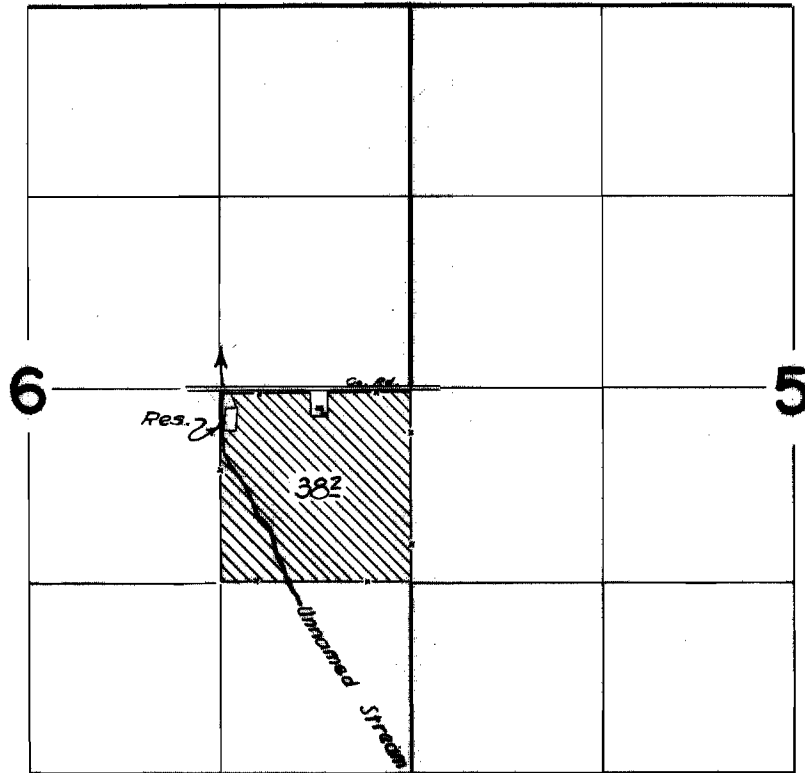

FINAL PROOF SURVEY UNDER

R-34503 R-2580
Application No. 34504 Permit No. 27137.....
IN NAME OF

ARNOLD MOORE JR.

Surveyed May 2, 1963, by

[Handwritten Signature]