T.4S. R.1E. W.M.

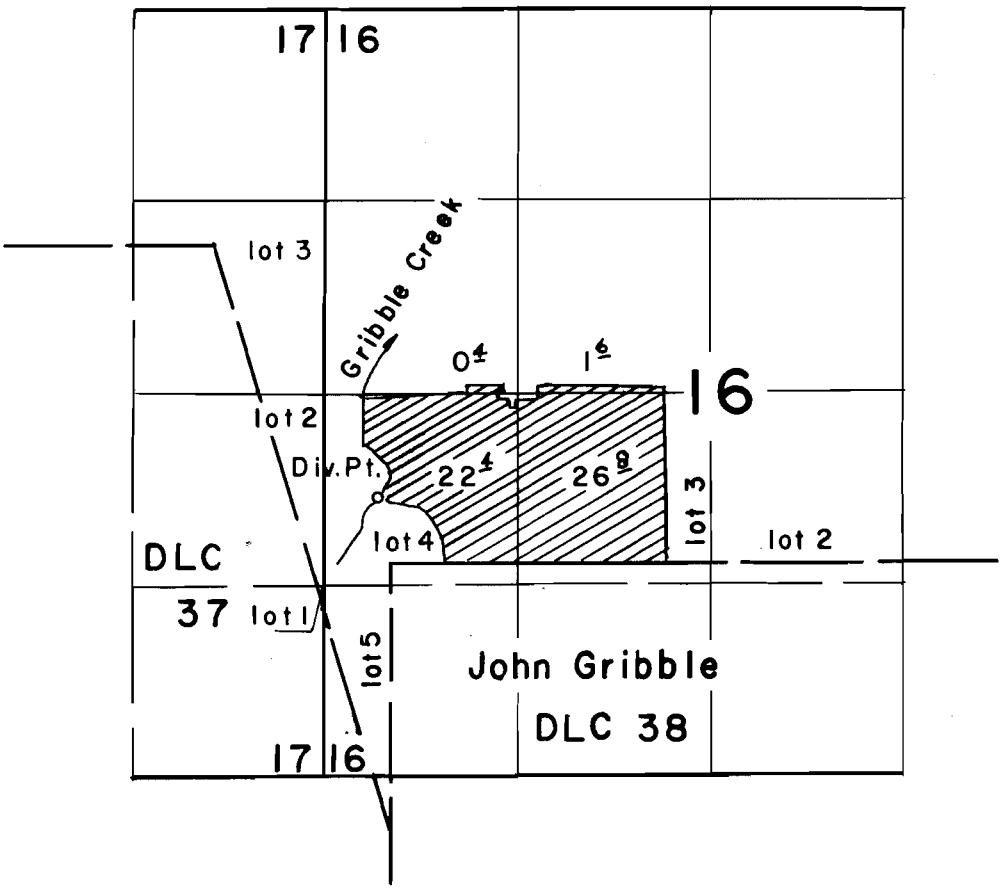

FINAL PROOF SURVEY
UNDER

Application No. 37290 Permit No. 27774
IN NAME OF

Oscar Bolland

Surveyed Sept. 2 1964, by C.J. Gardner

DFK-1P-84