


T.2S.R.6E.W.M.

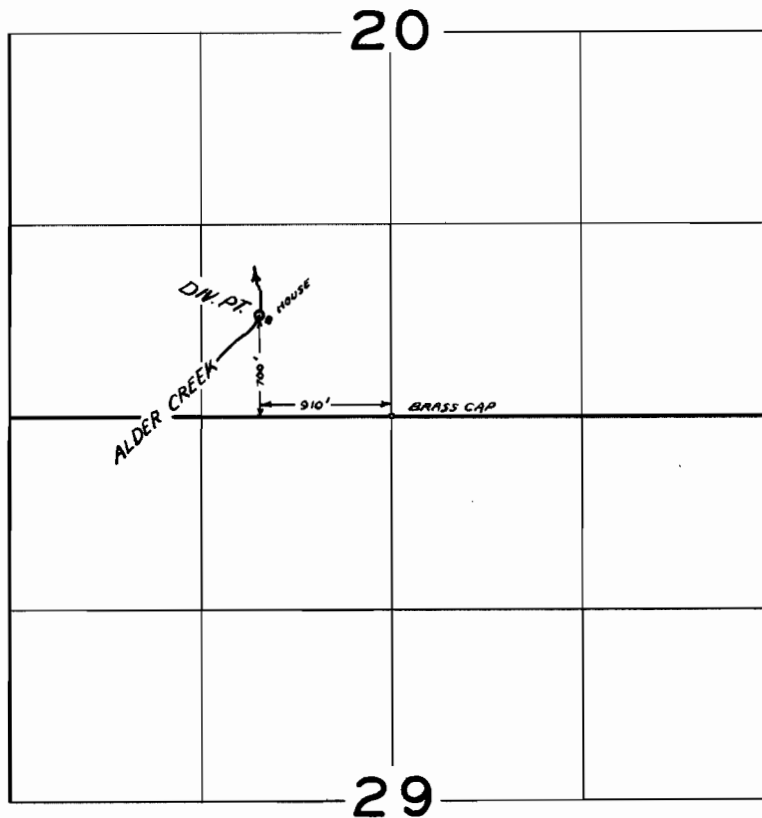

FINAL PROOF SURVEY
UNDER

Application No. 38346 Permit No. 28541

IN NAME OF

CLARENCE C. HALLBERG

Surveyed SEP. 7 1965, by C. GARDNER