


T.23S. R.11W. W.M.

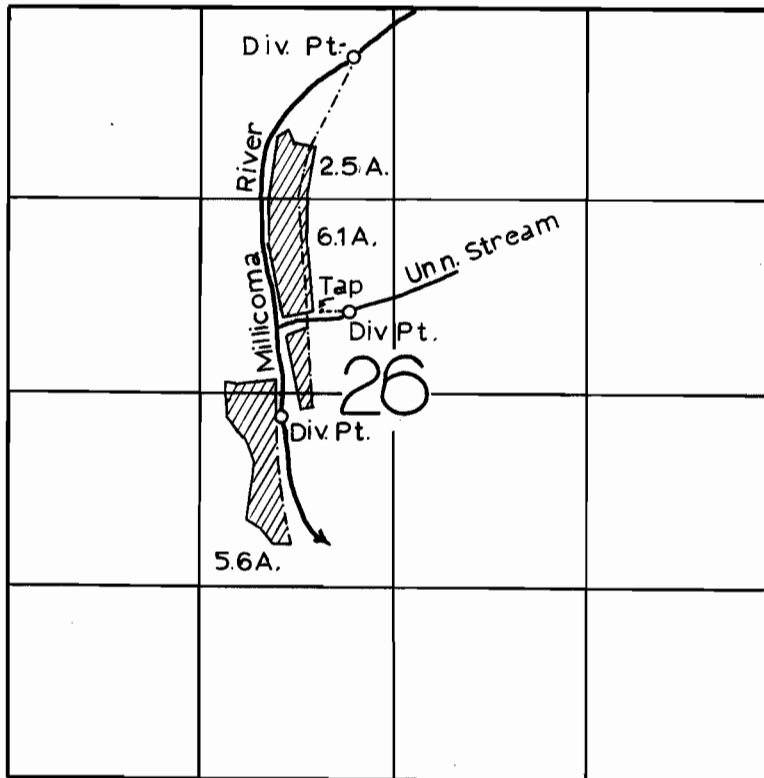

**FINAL PROOF SURVEY**  
UNDER

Application No. 38096 Permit No. 28399  
IN NAME OF

GLAE C. GOULD

Surveyed SEPT 27 1965, by W. J. RUPPERT