


T.27S. R.7W. W.M.

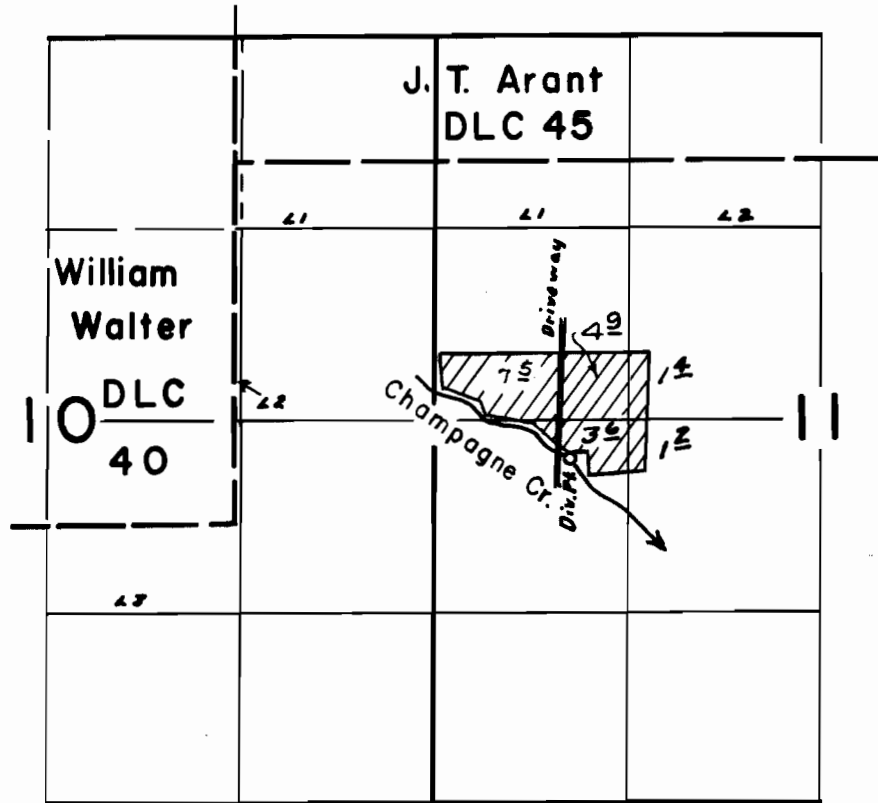

**FINAL PROOF SURVEY**  
UNDER

Application No. 32764 Permit No. 25893  
IN NAME OF  
**C. M. YOUNG**

Surveyed July 16, 1964, by C. J. Gardner