


T.30S. R.3W. W.M.

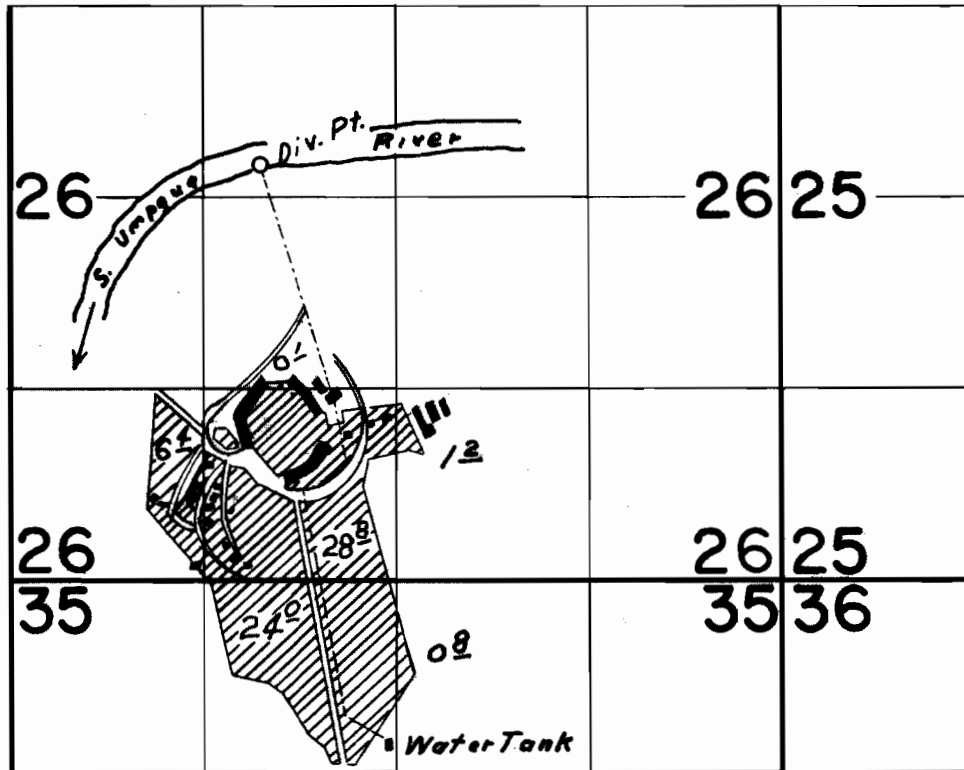

**FINAL PROOF SURVEY**  
UNDER

Application No. 33329 Permit No. 27182  
IN NAME OF

**MILO ACADEMY INC.**

Surveyed Aug. 6, 1964, by *C.V. Gardner*