


T.26S. R.1W. W.M.

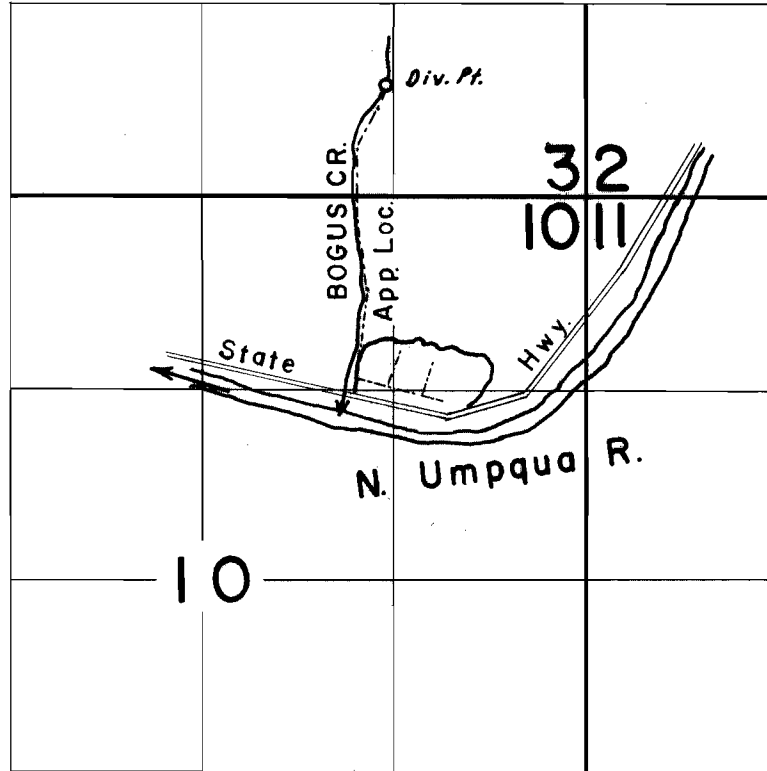

**FINAL PROOF SURVEY**  
UNDER

Application No. 37148 Permit No. 27710  
IN NAME OF

**U.S. DEPARTMENT OF AGRICULTURE**

Surveyed July 29, 1964, by C. J. Harder