


T.26S. R.2E. W. M.

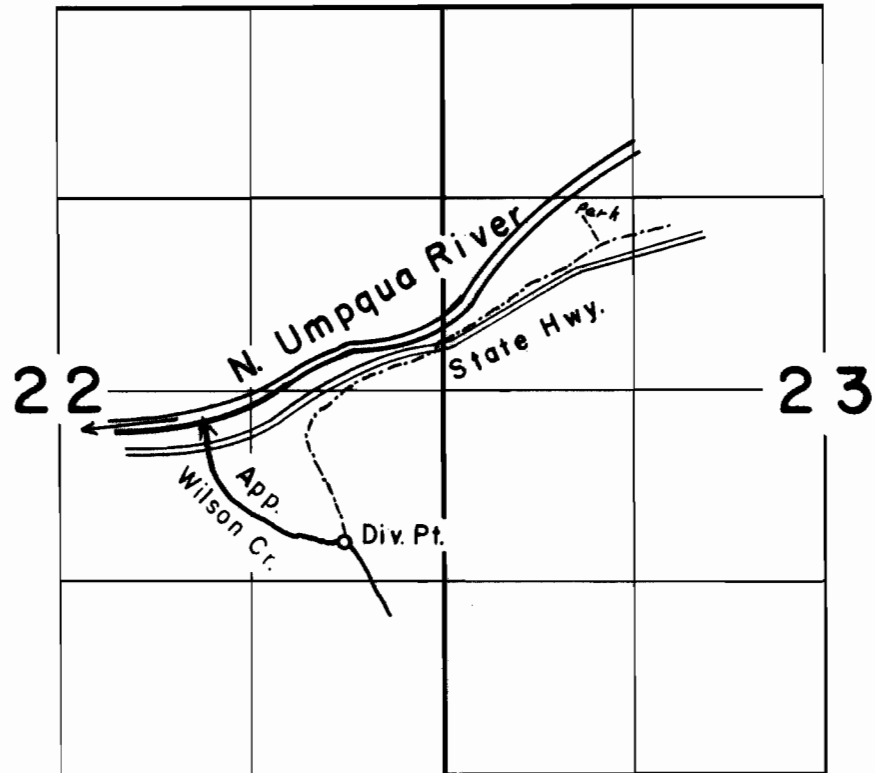

FINAL PROOF SURVEY
UNDER

Application No. 37231 Permit No. 27747
IN NAME OF

U. S. FOREST SERVICE

Surveyed July 28, 1964, by C. J. Gordon