


T.27S. R.2W. W.M.

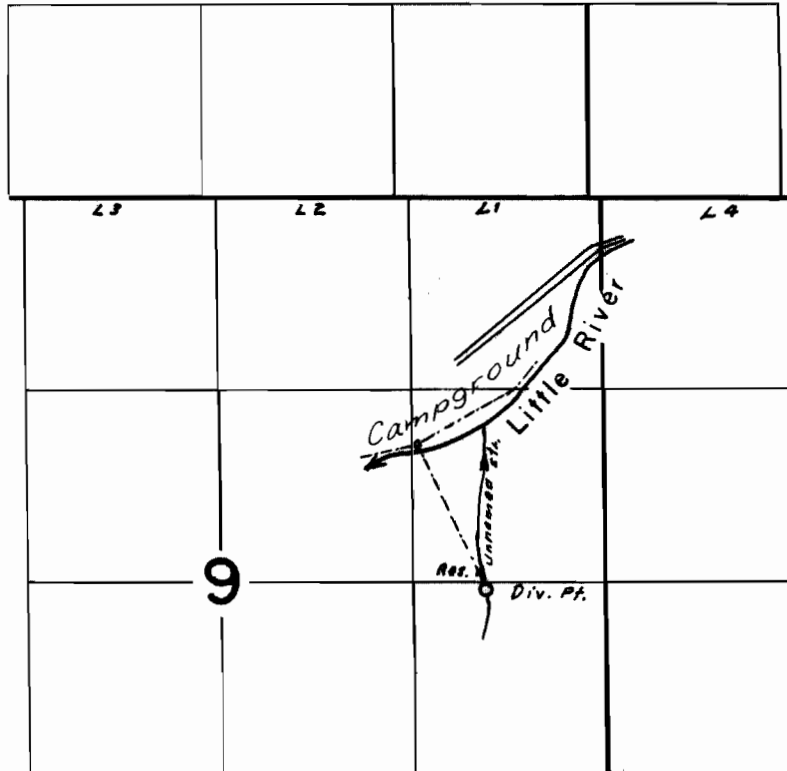

FINAL PROOF SURVEY
UNDER

Application No. 38490 Permit No. 28715
IN NAME OF

U.S. DEPARTMENT OF AGRICULTURE

Surveyed July 28, 1964, by *C. J. Landre*