


Per 25409
33055

T.9S.R.32E.W.M.

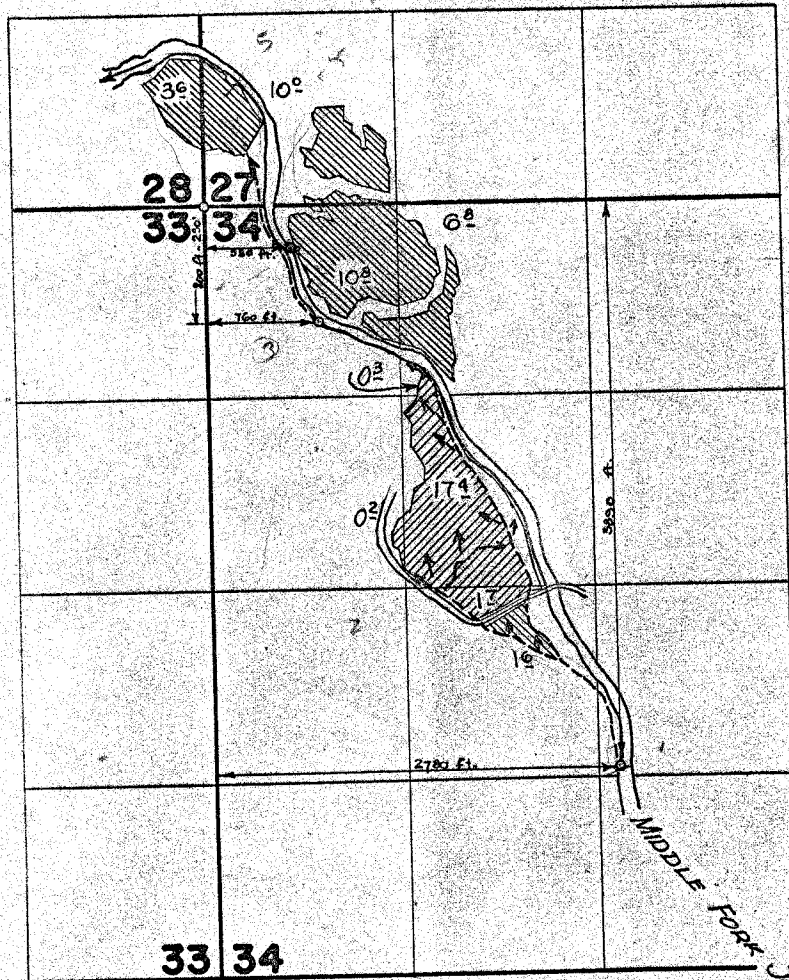

Primary
Supplemental

FINAL PROOF SURVEY
UNDER

Application No. 32158..... Permit No. 25409....
IN NAME OF

PHILIP W. MURPHY

Surveyed Oct. 22 1964, by *R. Jackson*