


Basin 6

P-25442

33056

T.9S.R.32E.W.M.

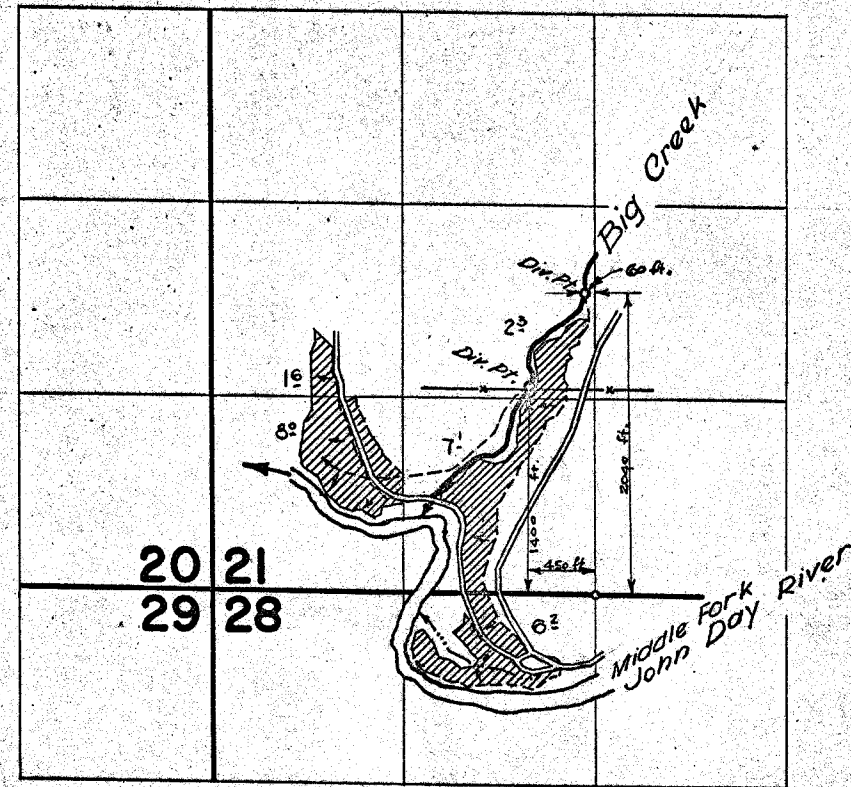

FINAL PROOF SURVEY
UNDER

Application No. 32252... Permit No. 25442...
IN NAME OF

PHILIP W. MURPHY

Surveyed Oct. 21, 1964, by *R. Johnson*