


(Basin 6
Final Proof by Insp.)

P-28017

33057

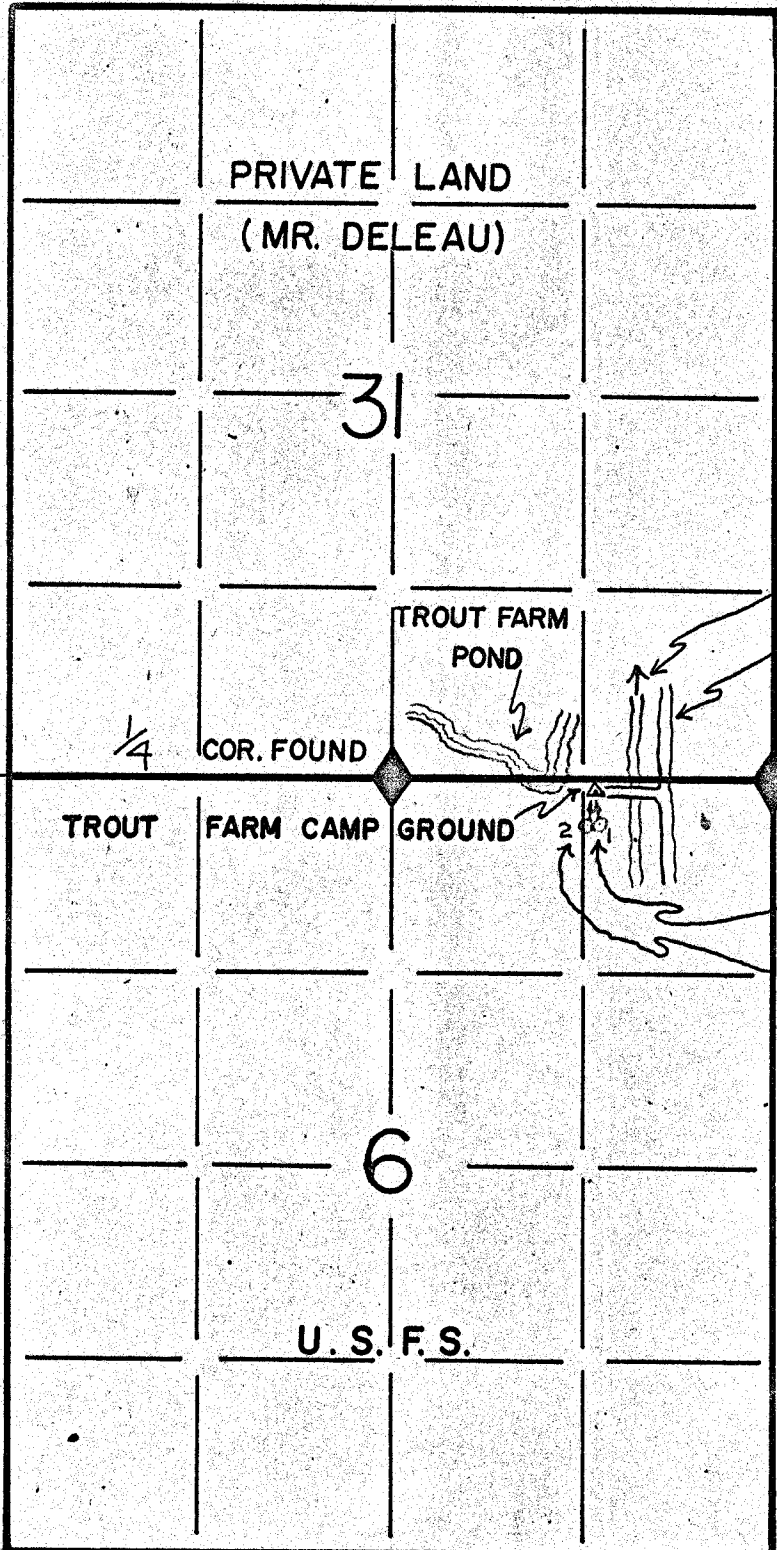

T.14S. R.35E. W.M.
T.15S. R.35E. W.M.

JOHN DAY RIVER
PRAIRIE-DREWSEY RD.
SEC. COR., WITH BT'S FOUND

SPRING 1 IS S.76°32'W,
1276 FT. FROM S.E. COR.
OF SEC. 31.

SPRING 2 IS S.77°W,
1320 FT. FROM S.E. COR.
OF SEC. 31.

RECEIVED
DEC 15 1961

RECEIVED
JAN 12 1962
STATE ENGINEER
SALEM, OREGON

LEGEND 4" = 1 MILE

Application No. 37300
Permit No. 28017