


T.36S.R.1E.W.M.

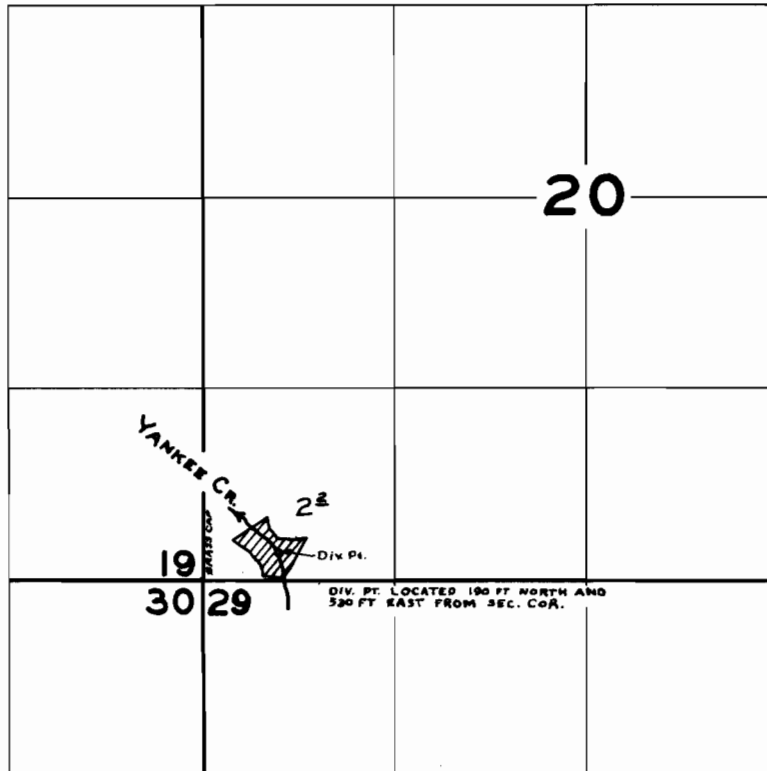

**FINAL PROOF SURVEY**  
UNDER

Application No. 32137 Permit No. 25351  
IN NAME OF

HOWARD VEACH

Surveyed Jul. 1 1965, by APBnell