


6-1296

33060

33258

T.40S.R.11E.W.M.

Lost River Wells

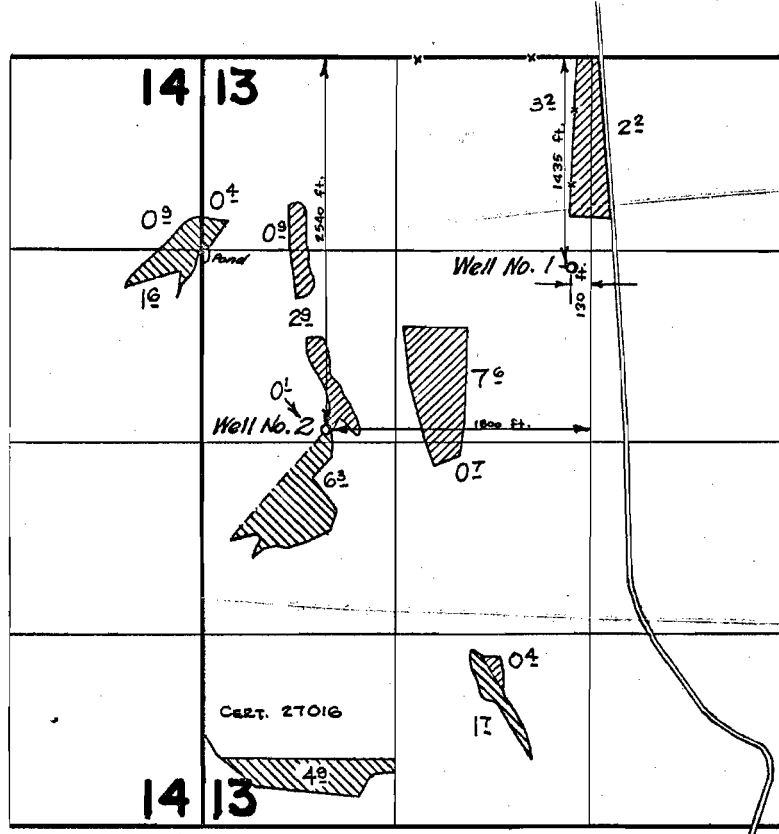

Well No. 1 
 Well No. 2 

FINAL PROOF SURVEY UNDER

Application No. G-1404 Permit No. G-1296
IN NAME OF

LADDIE & CARL RAJNUS

Surveyed June 9, 1964, by *R. Jackson*