

Will. Rv. Well

T.30S.R.88&9E.W.M.

FINAL PROOF SURVEY


UNDER

Application No. 34534 Permit No. 27139
G-1901 G-1756

IN NAME OF

C. C. PINNEO

Surveyed Sept. 28-29-30, 1965 by *L.H. Jackson*

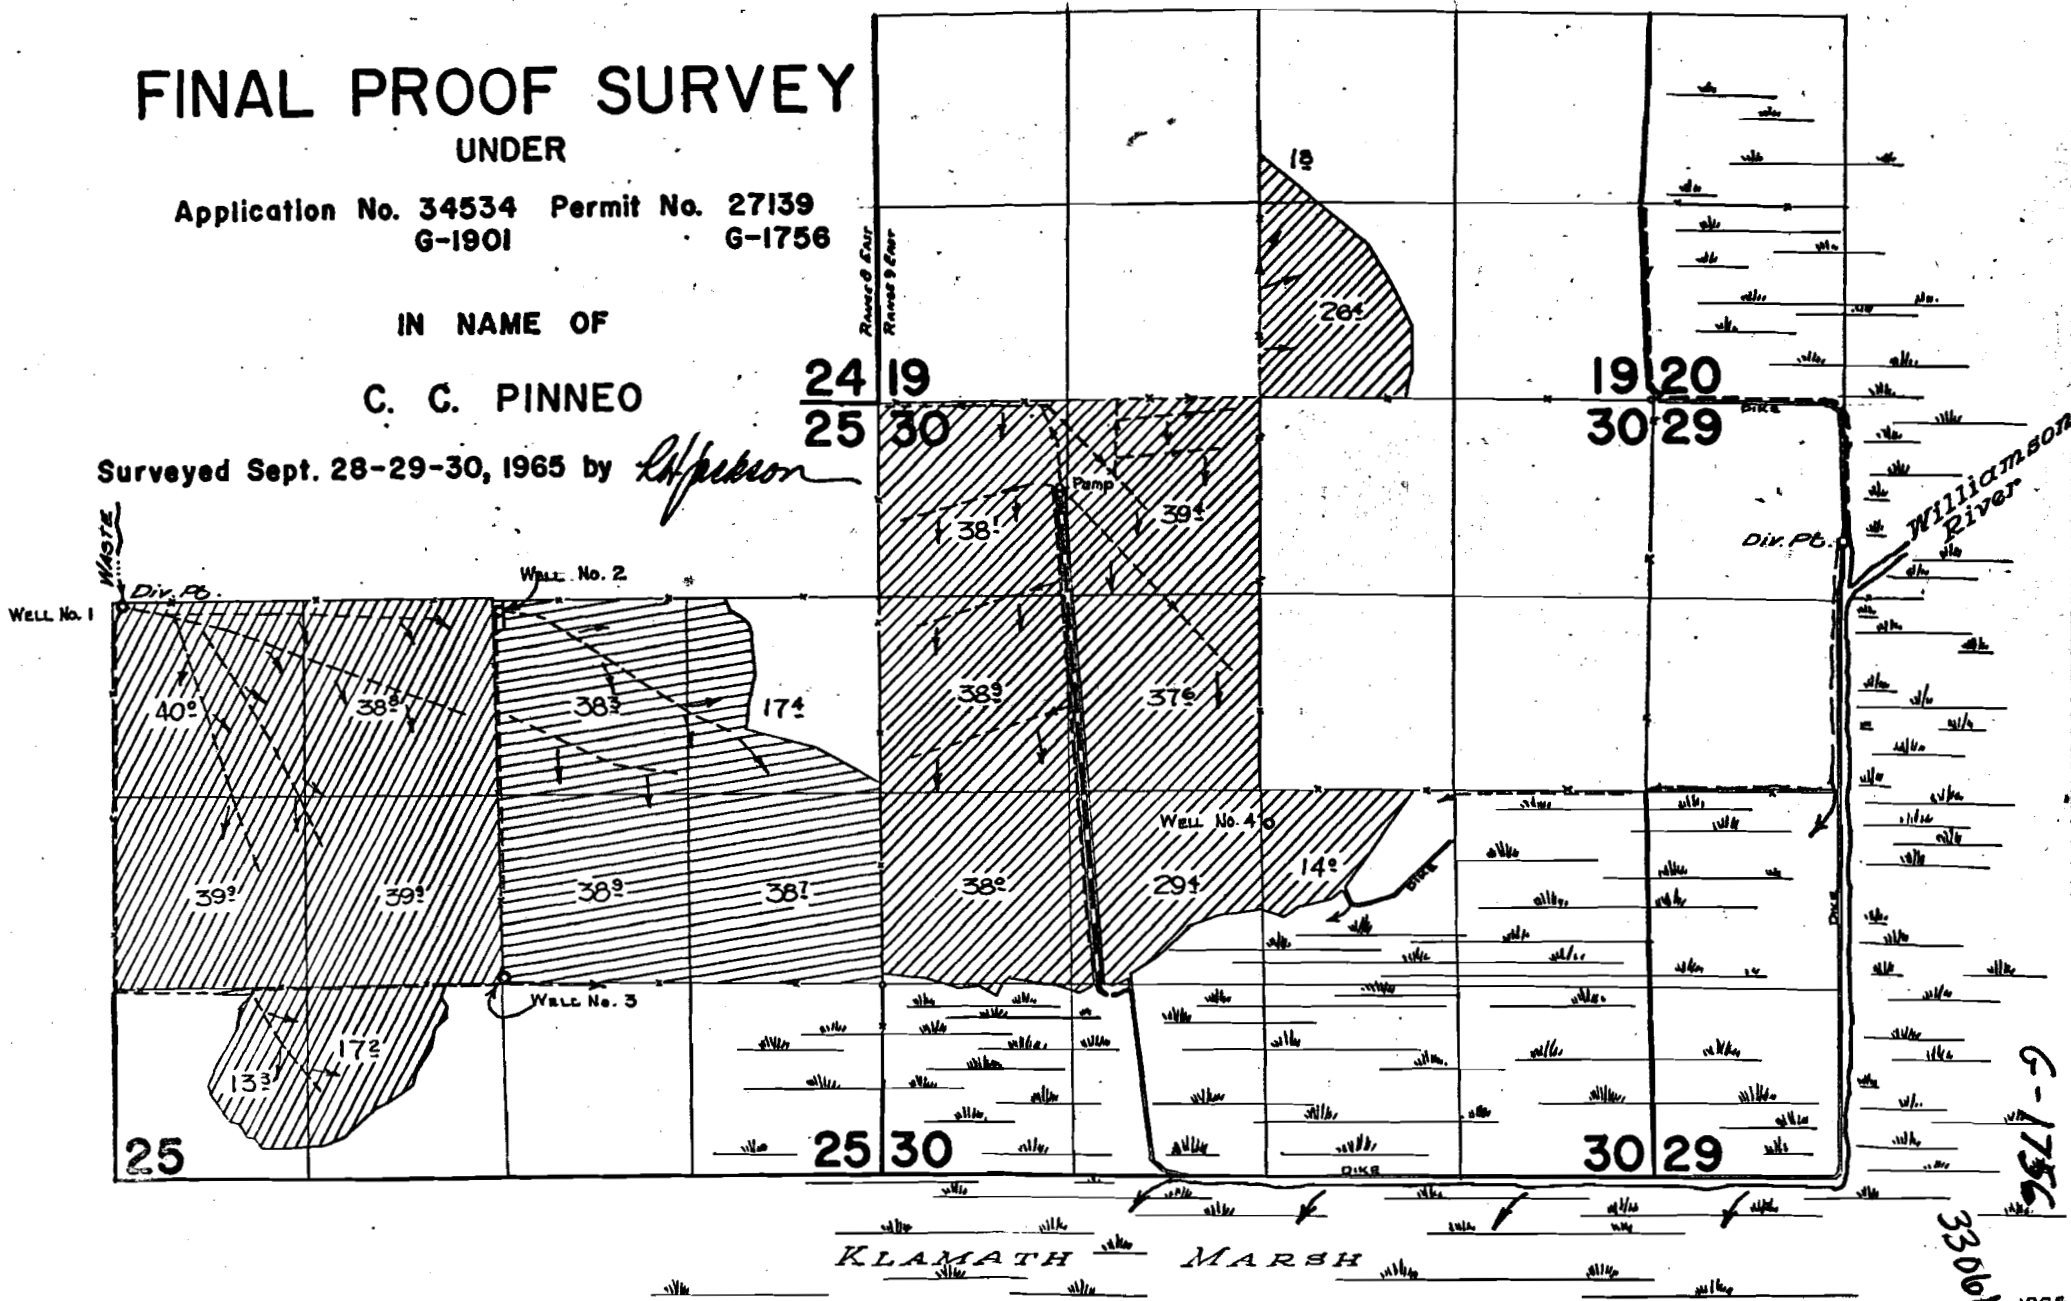

G-1756
33091