


G-2152  
33062

# T.31S.R.8E.W.M.

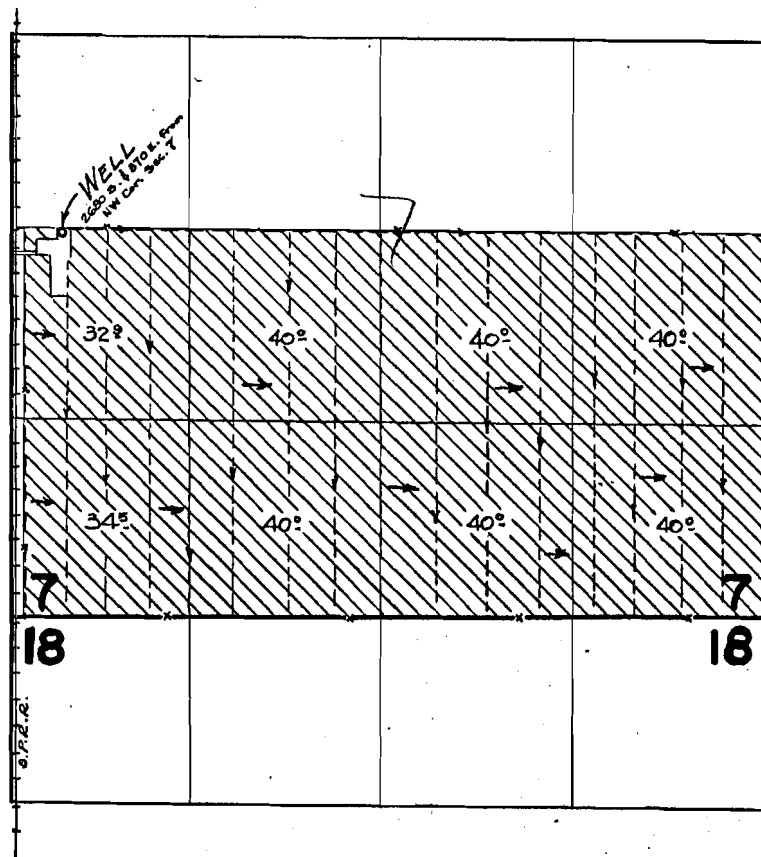

Scott 1 Sand Ck. well

## FINAL PROOF SURVEY UNDER

Application No. G-2328 Permit No. G-2152  
IN NAME OF

F. MILES MAYFIELD

Surveyed May 23 1964, by *Hyenson*