


T.30S R.10E W.M

Williamson River

18

T.30S R.10E W.M.
T.30S R.11E W.M.

13 18

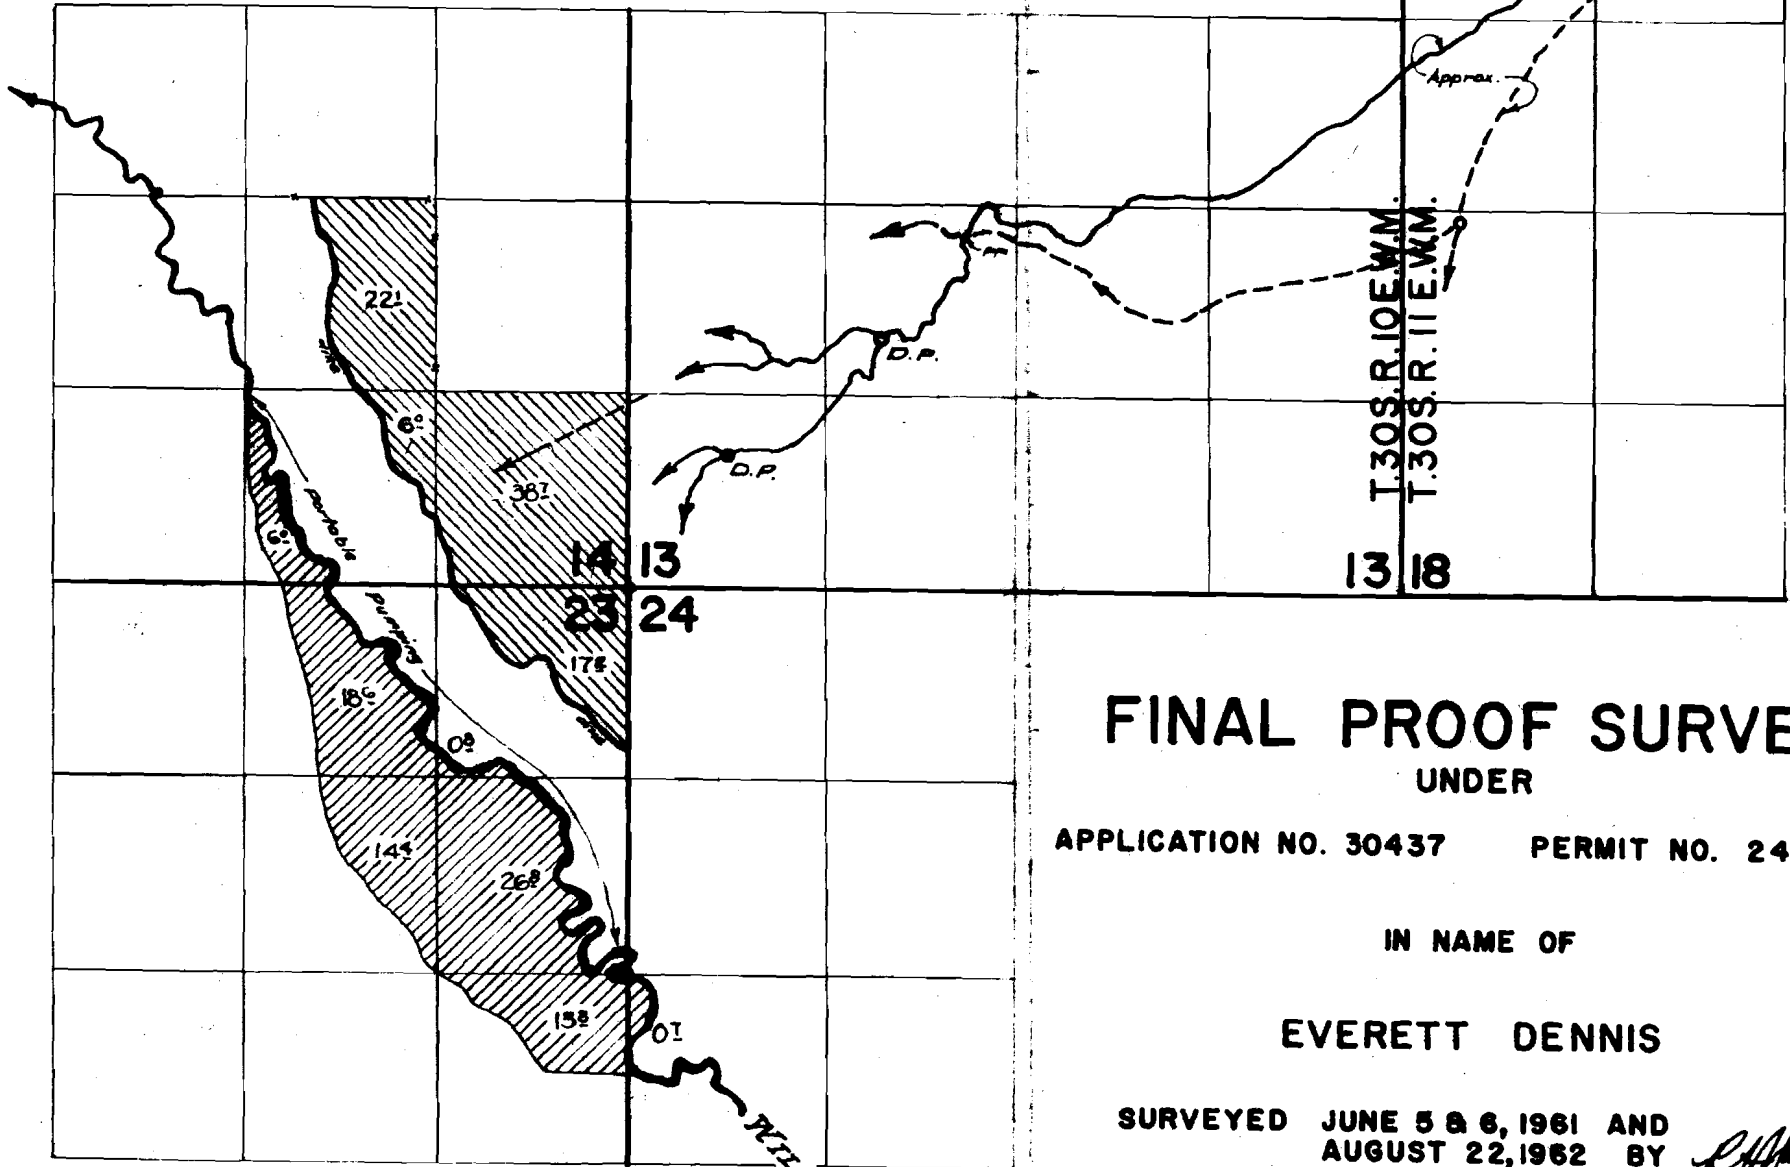

FINAL PROOF SURVEY

UNDER

APPLICATION NO. 30437

PERMIT NO. 24669

IN NAME OF

EVERETT DENNIS

SURVEYED JUNE 5 & 6, 1961 AND
AUGUST 22, 1962 BY

R. Jackson

24669
33063