


T.36S.R.11E.W.M.

Sprague River misc.

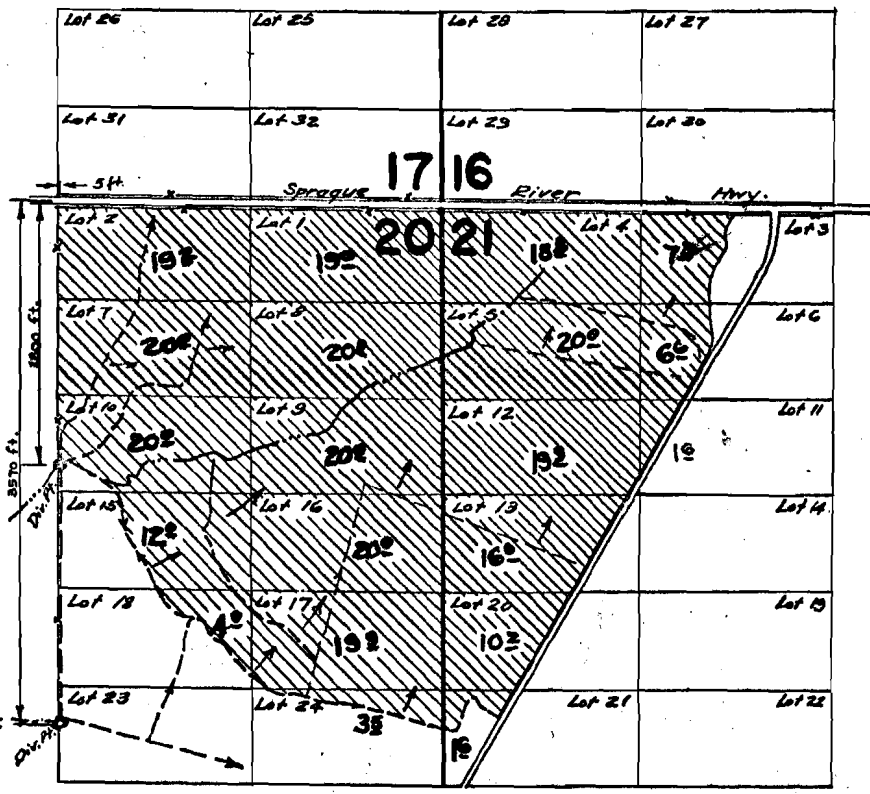

FINAL PROOF SURVEY UNDER

Application No. 33597... Permit No. 26566...
IN NAME OF

BENJAMIN & BESSIE BERTRAN

Surveyed August 20, 1964, by *Spekum*