

14  
Opp. No. G-3407 Williamson Ro.  
Per. No. G-3581

T.30S.R.8&9E.W.M.

# FINAL PROOF SURVEY


UNDER

Application No. 34534 Permit No. 27139  
G-1901 G-1756

IN NAME OF

C. C. PINNEO

Surveyed Sept. 23-29-30, 1965 by *R. Peterson*

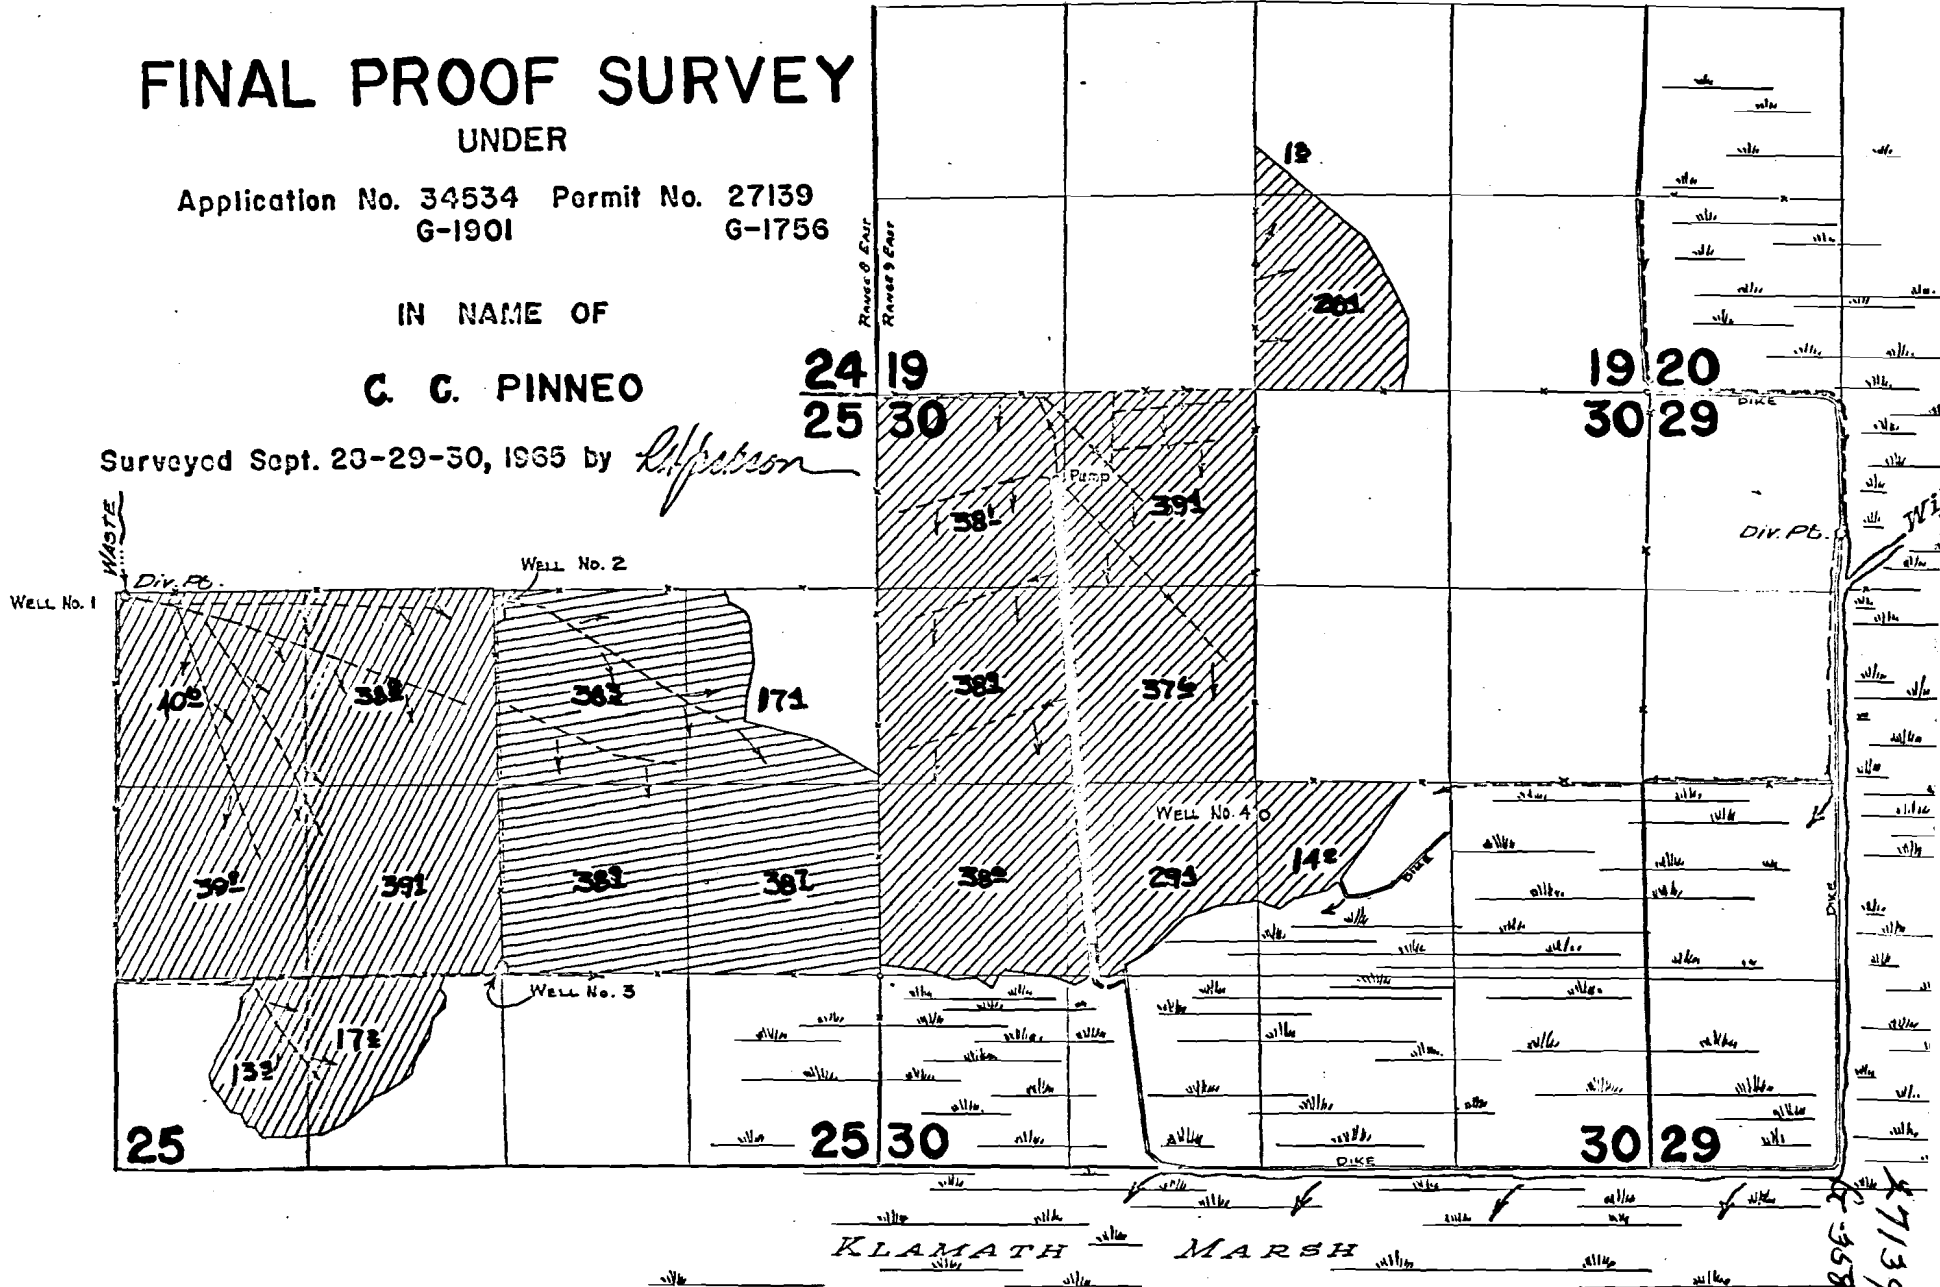

33065

47139  
G-3581