
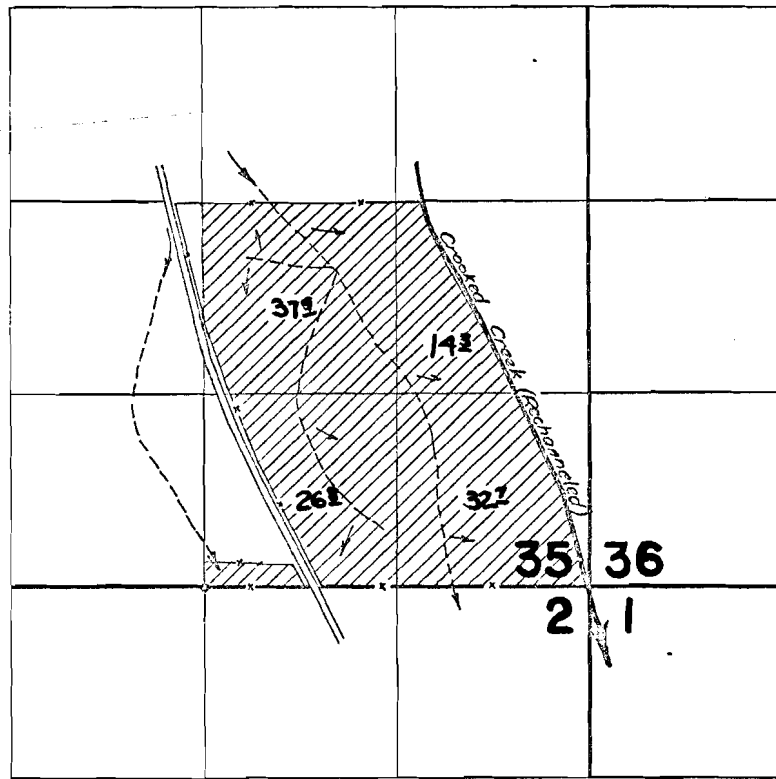


# T.33S.R.7½E.W.M.

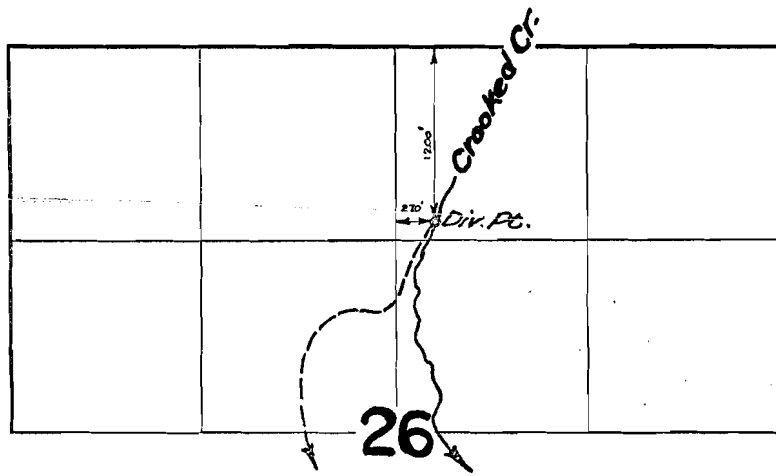

*Crooked Creek Meas.*

## FINAL PROOF SURVEY UNDER

Application No. 39050... Permit No. 29078...  
IN NAME OF

**LLOYD NICHOLSON**

Surveyed August 19, 1964, by *A. Jackson*