




# T.40S.R.19E.W.M.

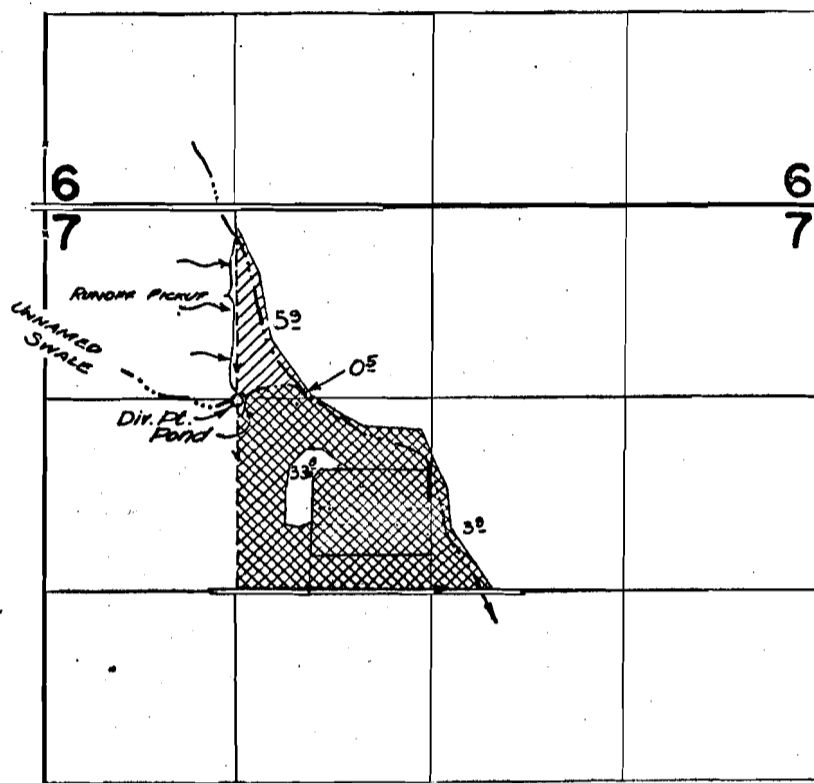

 Irrigated from runoff  
 Irrigated from Swale

$$\frac{810 \times 590}{13560} = 11.02 \text{ ac}$$

## FINAL PROOF SURVEY UNDER

Application No. 33982..... Permit No. 27311.....  
IN NAME OF

..... R. F. RICHARDSON .....

Surveyed Sept. 15, 1962, by T. Lauer.....  
Sept. 15, 1964, by R. Jackson

48-190 ✓