


T.16S. R. 4 W. W.M.

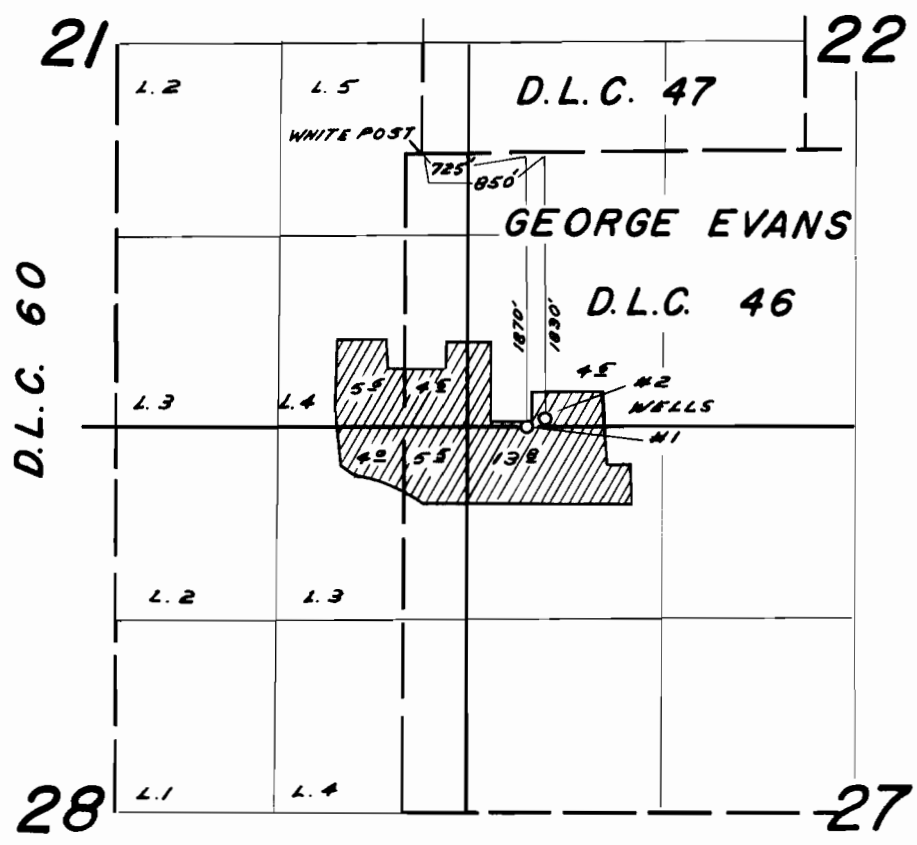

FINAL PROOF SURVEY
UNDER

Application No. G-2283 Permit No. G-2109
IN NAME OF

WILL E. BISHOP

Surveyed APR. 27 1965, by L. COLEBANK