


T. 17 S. R. 11 W. W.M.

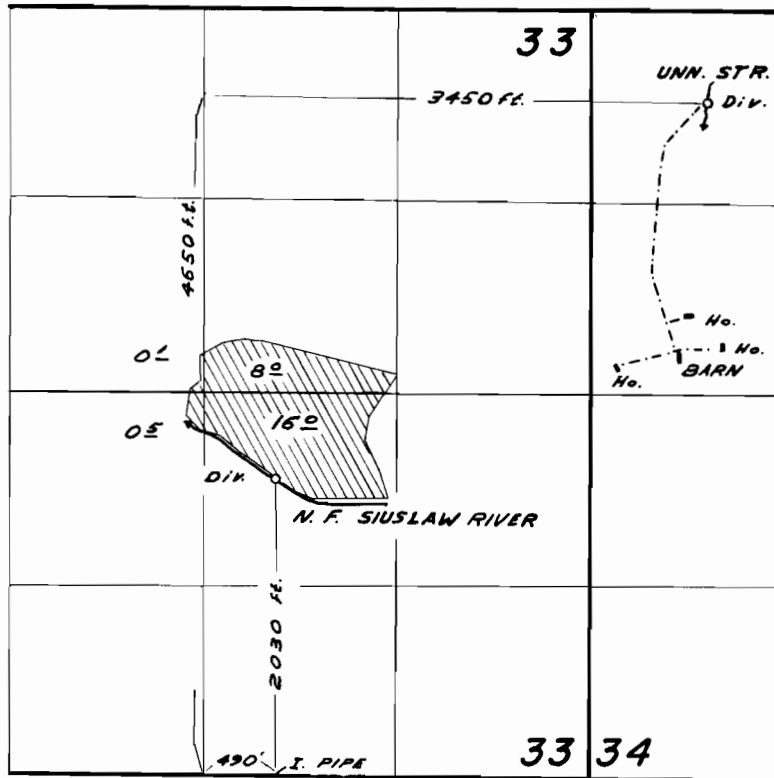

FINAL PROOF SURVEY
UNDER

Application No. 34644 Permit No. 27214
IN NAME OF

NOLAND J. HUNTINGTON

Surveyed JUNE 11 1965, by L. COLEBANK