


T.21S.R.3W.W.M.

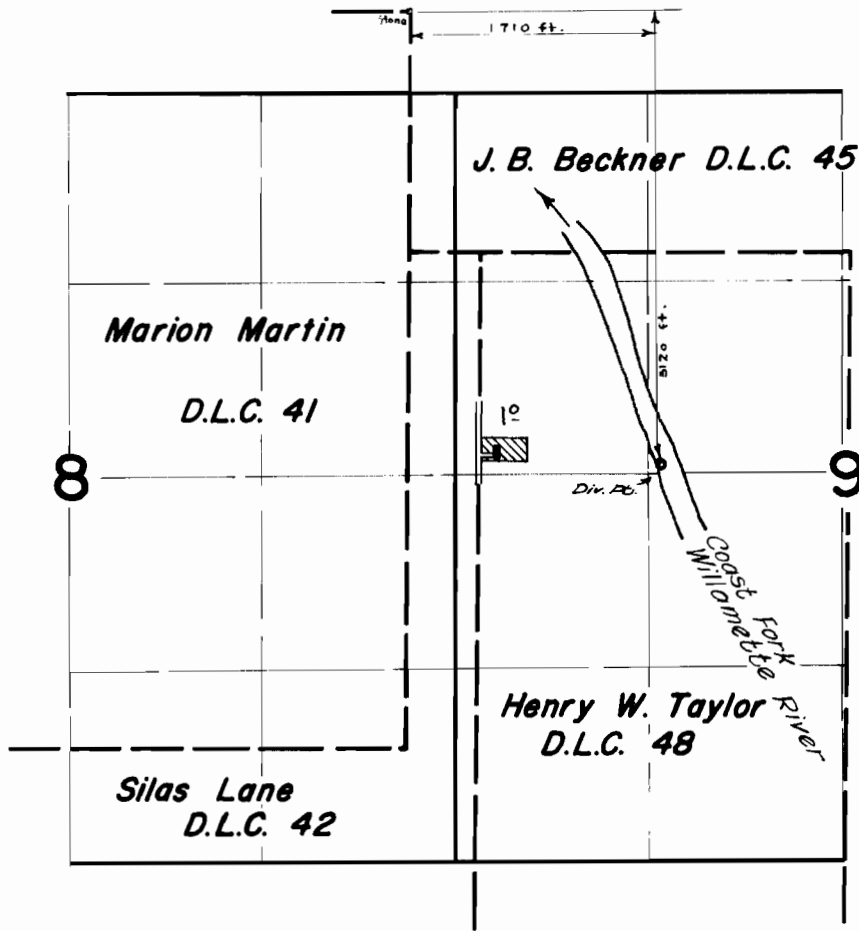

FINAL PROOF SURVEY
UNDER

Application No. **37080** Permit No. **27604**
IN NAME OF

L. DOYLE SHEPHERD

Surveyed *May 5*, 1965, by *Shepherd*