


T.19S. R.12W. W.M.

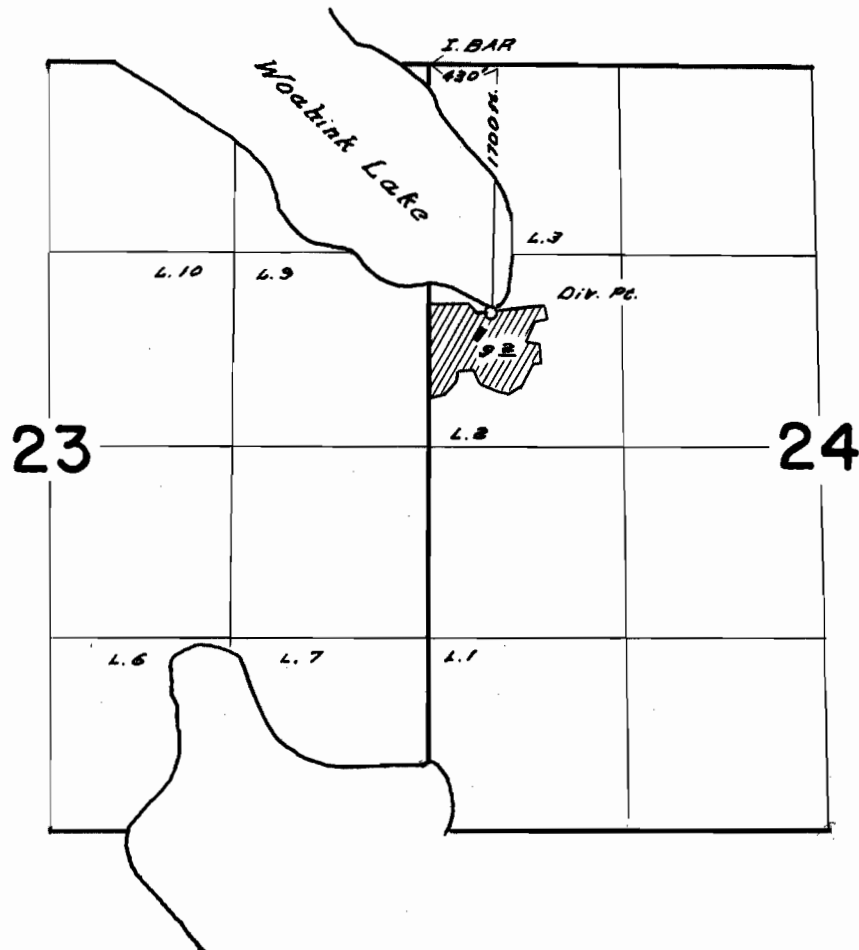

FINAL PROOF SURVEY
UNDER

Application No. 38491 Permit No. 28660
IN NAME OF

A. J. BRAUER

Surveyed JUNE 7 1965, by L. COLEBANK