


T.17S. R.11W. W.M.

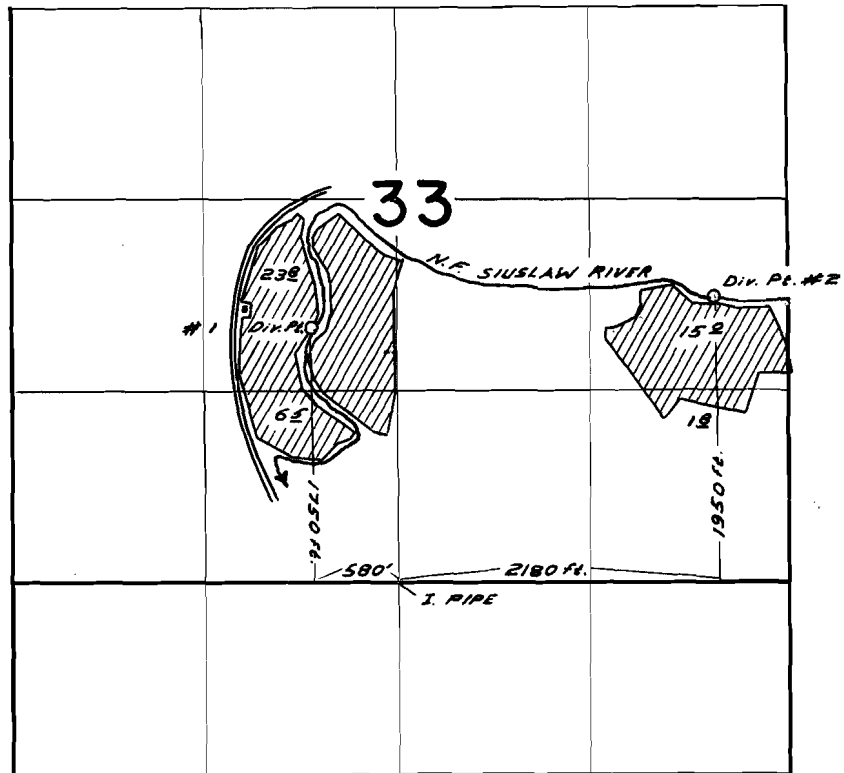

FINAL PROOF SURVEY
UNDER

Application No. 39939 Permit No. 29726
IN NAME OF

HERBERT C. OR DORCAS L. HOUGHTON

Surveyed JUNE 9 1965, by L. COLEBANK