


T.19S. R.12W. W.M.

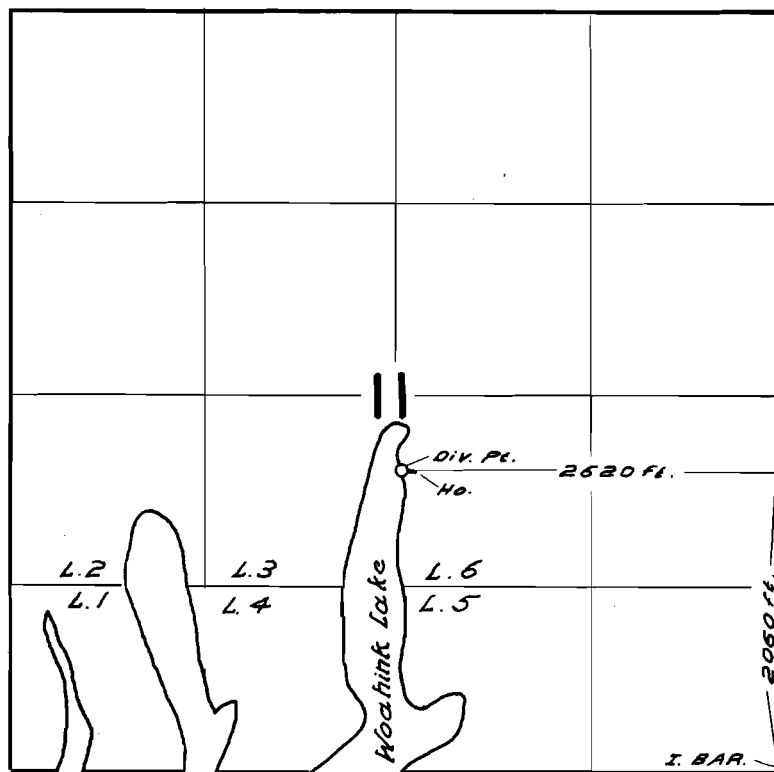

FINAL PROOF SURVEY
UNDER

Application No. 39973 Permit No. 29743
IN NAME OF

LEAVITT C. WRIGHT

Surveyed JUNE 9 1965, by L. COLEBANK