


T.17S. R.11W. W.M.

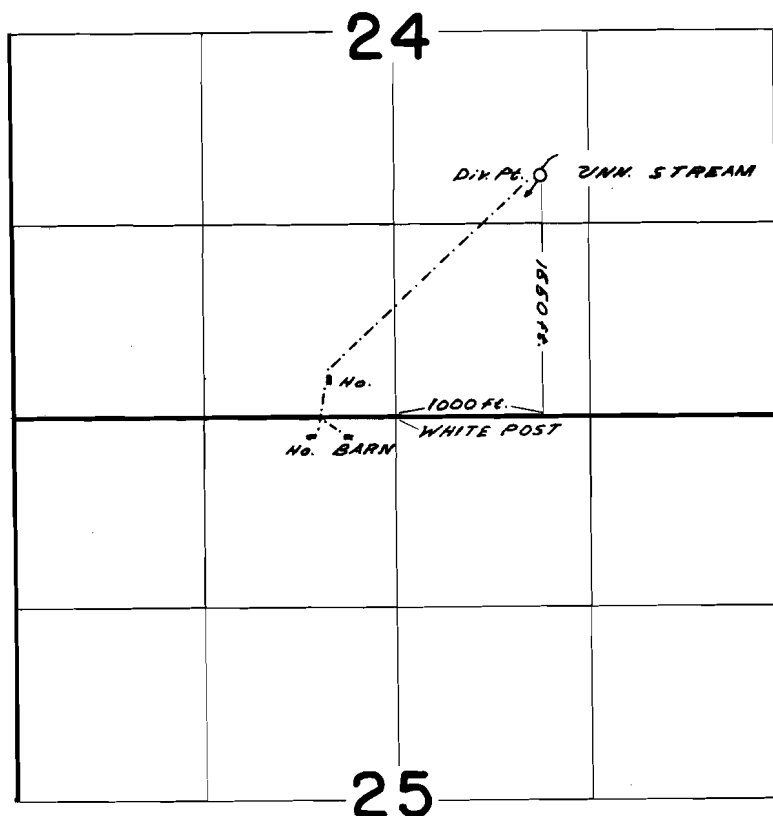

**FINAL PROOF SURVEY**  
UNDER

Application No. 39898 Permit No. 29836  
IN NAME OF

WILLIAM J. & LAVERN W. MEADOWS

Surveyed JUNE 8 1965, by L. COLEBANK