


T.18S. R.11W. W.M.

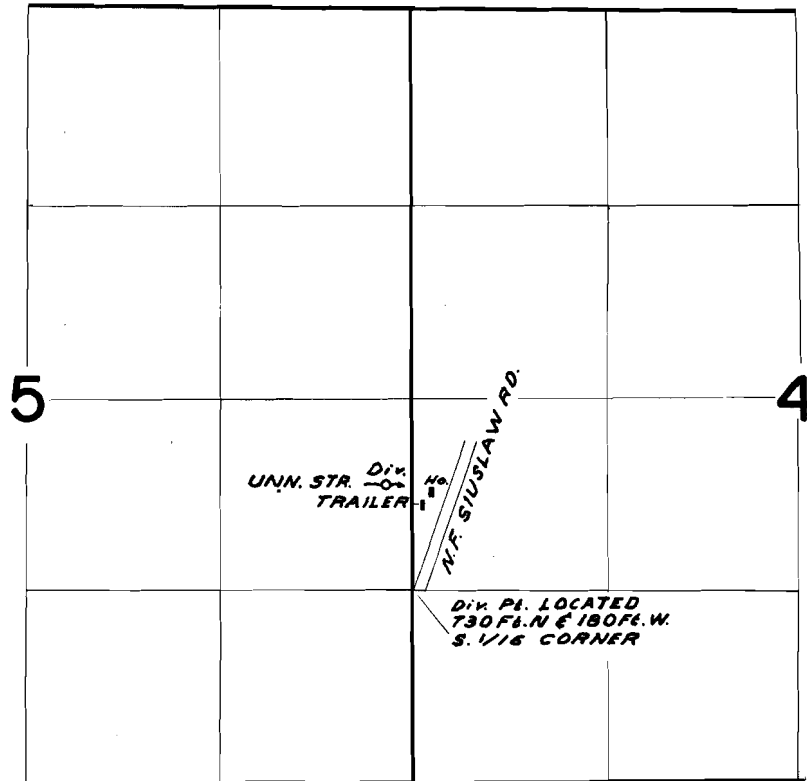

FINAL PROOF SURVEY
UNDER

Application No. 40030 Permit No. 29843
IN NAME OF

ROBERT H. & FAY S. CLARK

Surveyed JUNE 8 1965, by L. COLEBANK