


T.18S. R.3W. W.M.

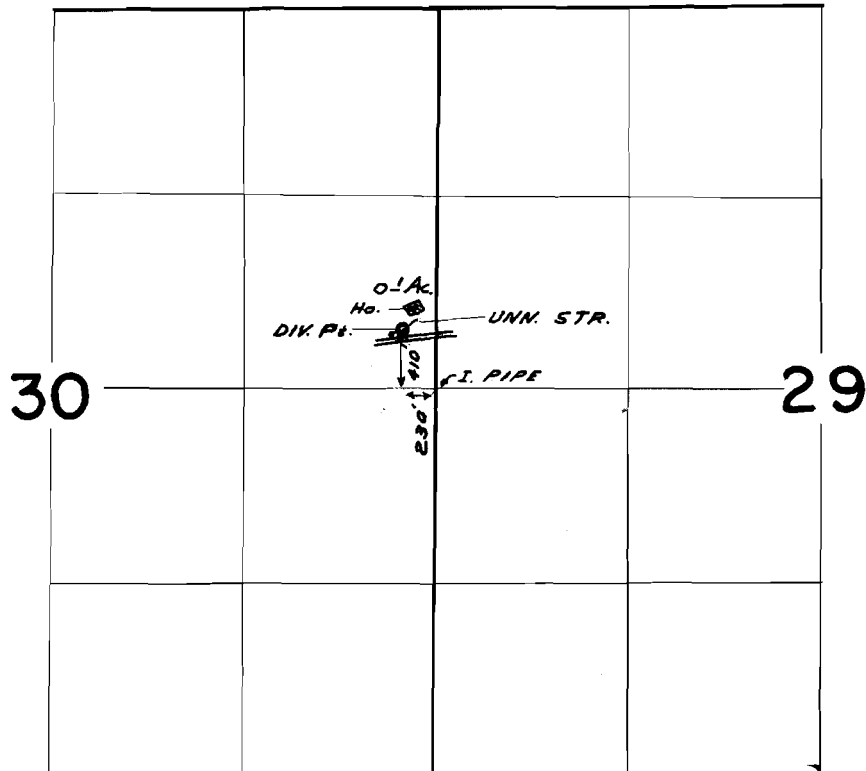

FINAL PROOF SURVEY
UNDER

Application No. 40153 Permit No. 29932
IN NAME OF

GORDON W. & DONNA B. JOHNSON

Surveyed APR. 30 1965, by L. COLEBANK