


T.17S. R.8 W. W.M.

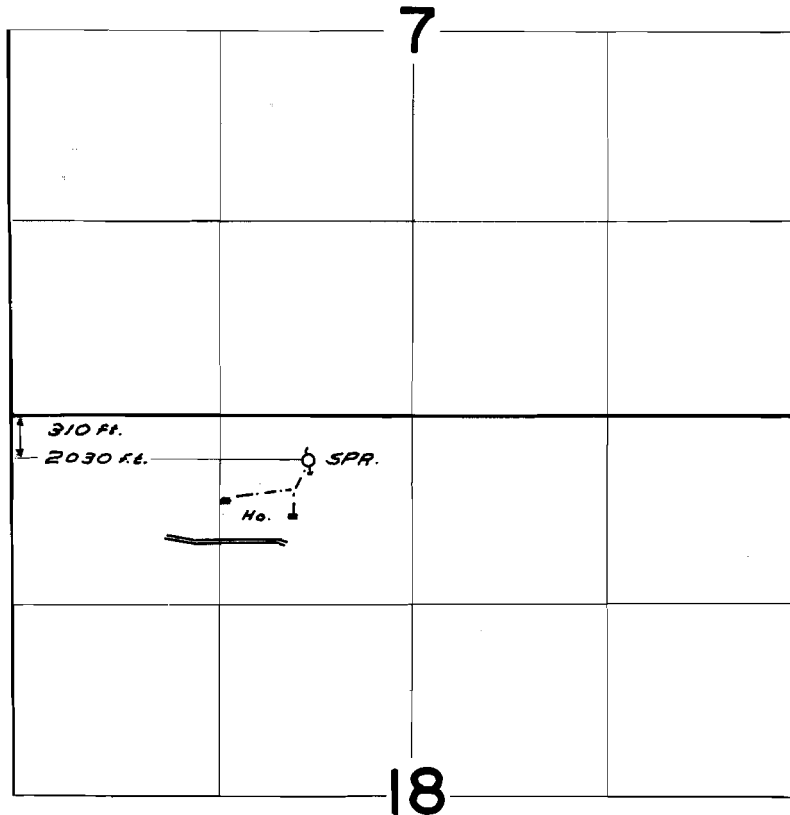

**FINAL PROOF SURVEY**  
UNDER

Application No. 40221 Permit No. 29998  
IN NAME OF

GARNET IOLA DROLLINGER

Surveyed JUNE 10, 1965, by L. COLEBANK