


T.11&12S.R.5 W.W.M.

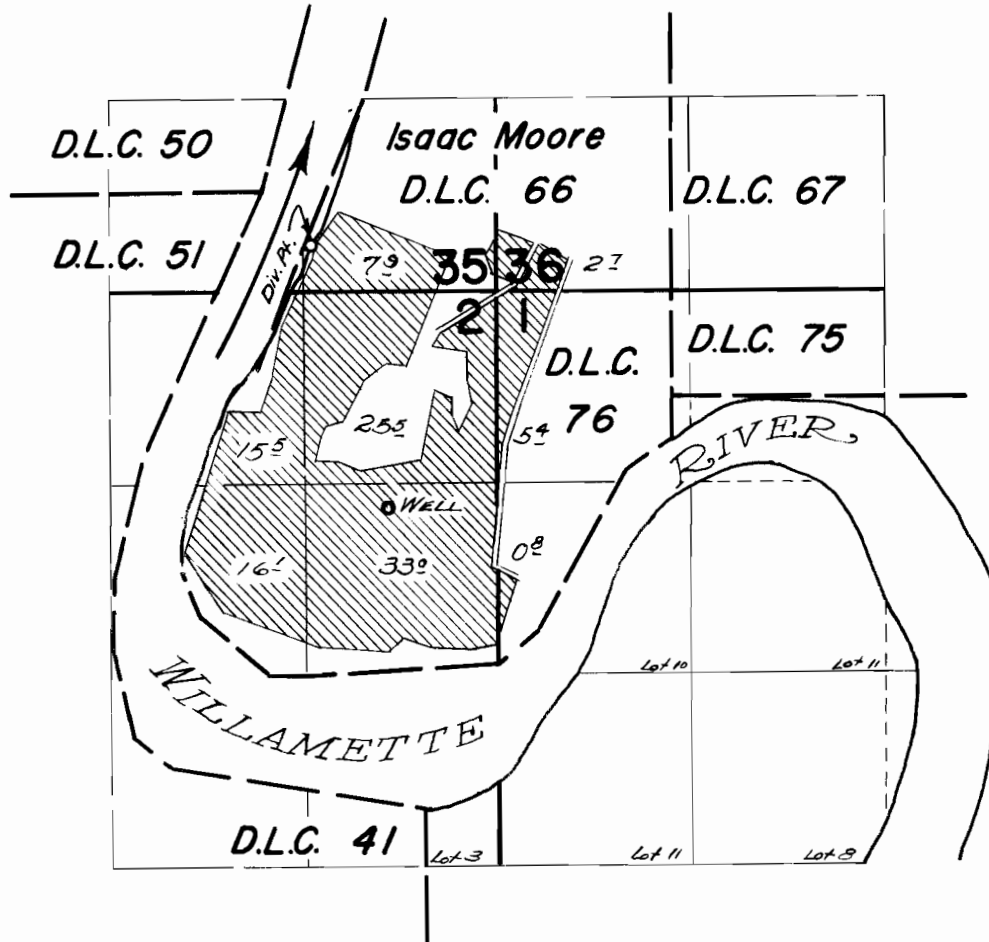

FINAL PROOF SURVEY
UNDER

Application No. 32468 Permit No. 25636
IN NAME OF

CLARK SAND and GRAVEL Co.

Surveyed May 3 1963 by C. Baker