


T.13&14S.R.4W.W.M.

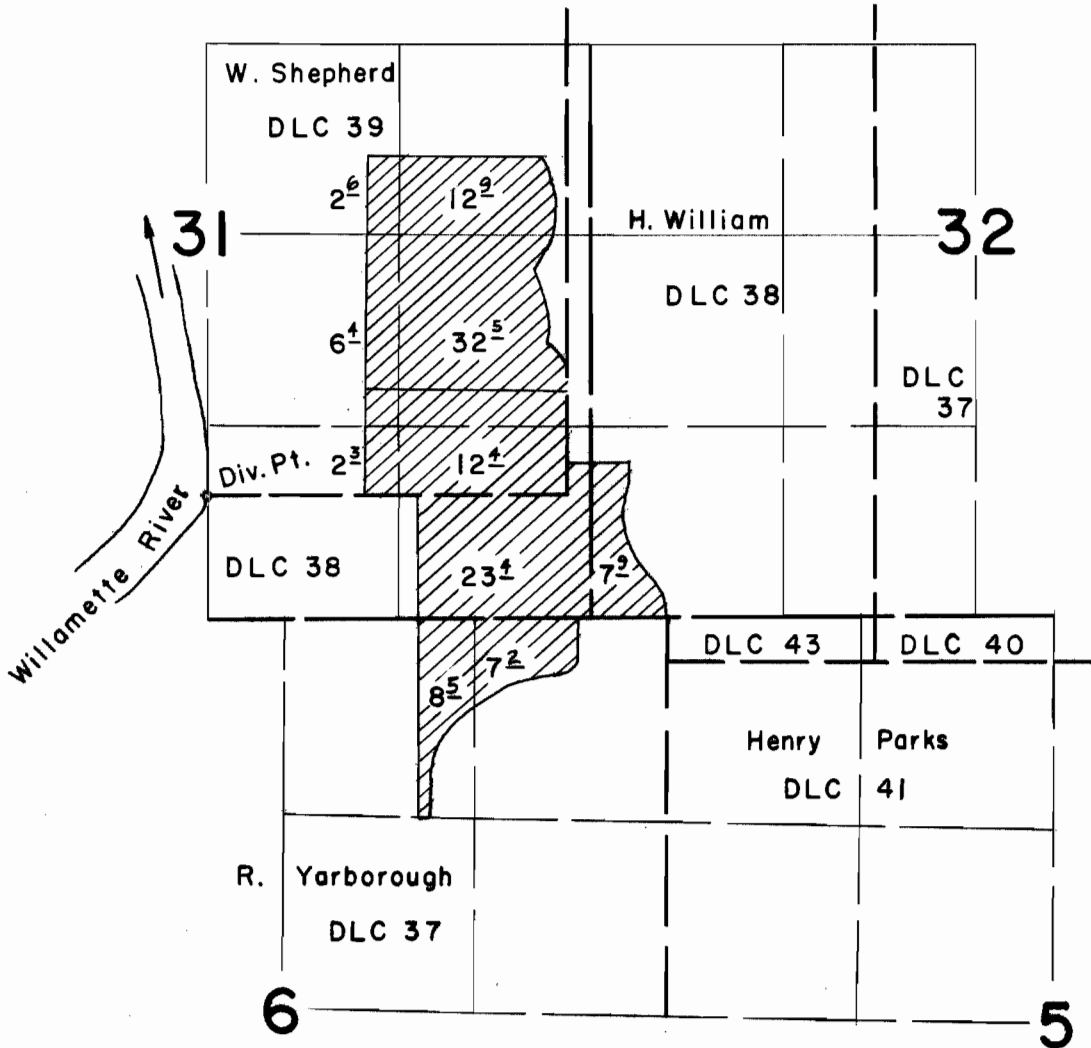

FINAL PROOF SURVEY UNDER

Application No. 33957 Permit No. 26722
IN NAME OF

..... Donald L. Bayne

Surveyed May 28 1963, by Carl Baker.....