


T.14 S. R.1 W. W.M.

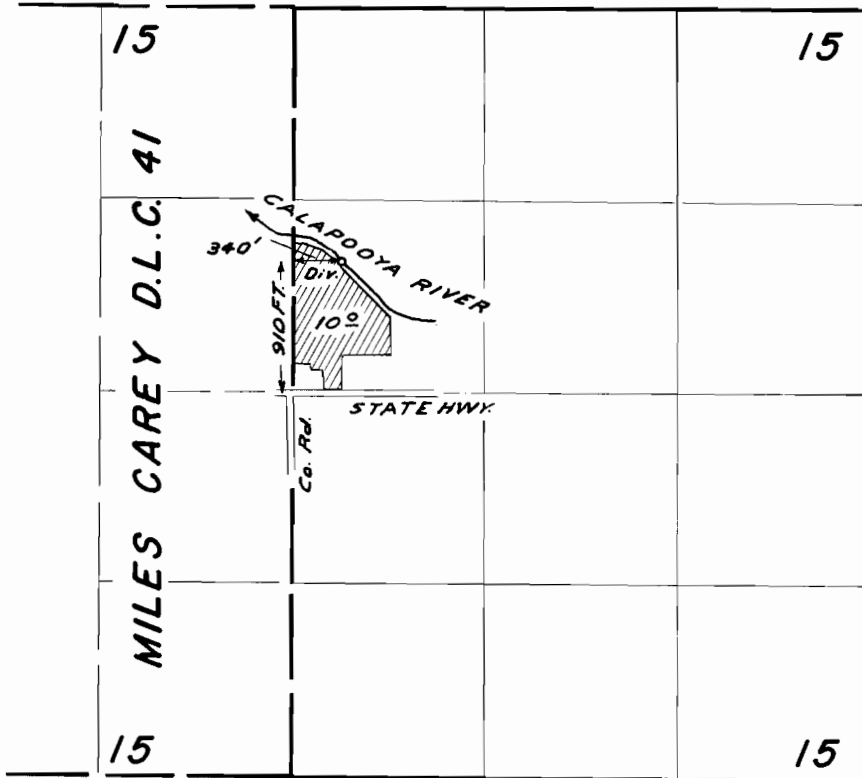

FINAL PROOF SURVEY
UNDER

Application No. 37794 Permit No. 28153
IN NAME OF

NORMAN E. & SHARAN R. SIMMS

Surveyed SEPT 29 1965, by L. COLEBANK